


Give All Information Completely
Make Required Affidavit
Mail or Deliver Report to:
Conservation Division
State Corporation Commission
211 No. Broadway
Wichita, Kansas

WELL PLUGGING RECORD

NORTH

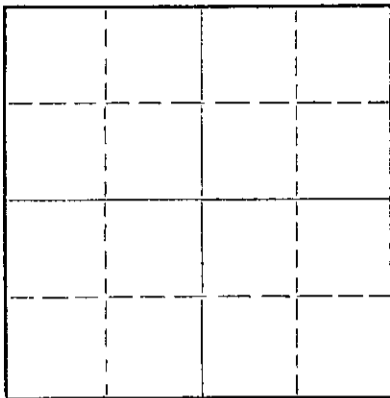

Locate well correctly on above
Section Plat

Harper County, Sec. 15 Twp. 31S Rge. 9W (E) (W)
Location as "NE/CNW/SW" or footage from lines C SW NW
Lease Owner The Texas Company
Lease Name Walter Miller Well No. 1
Office Address 614 Bitting Building, Wichita, Kansas
Character of Well (completed as Oil, Gas or Dry Hole) Dry
Date well completed November 16 19 57
Application for plugging filed September 30 19 58
Application for plugging approved October 1 19 58
Plugging commenced October 3 19 58
Plugging completed October 4 19 58
Reason for abandonment of well or producing formation

If a producing well is abandoned, date of last production 19
Was permission obtained from the Conservation Division or its agents before plugging was commenced? Yes

Name of Conservation Agent who supervised plugging of this well Mr. Fred Hampel
Producing formation Depth to top Bottom Total Depth of Well 4441 Feet
Show depth and thickness of all water, oil and gas formations. PBTB 4401

OIL, GAS OR WATER RECORDS

CASING RECORD

FORMATION	CONTENT	FROM	TO	SIZE	PUT IN	PULLED OUT
				8-5/8"	356	None
				5-1/2"	4440	3682

Describe in detail the manner in which the well was plugged, indicating where the mud fluid was placed and the method or methods used in introducing it into the hole. If cement or other plugs were used, state the character of same and depth placed, from feet to feet for each plug set.

Plugged as follows:

Pumped 50 sacks Cement to 4100'
Heavy Mud to 1600'
Circulated 60 sacks Howco Gel at 1600'
Heavy Mud to 240'
Rock Bridge 240' to 220'
20 Sacks Cement 220' to 156'
Rock Bridge 156' to 146'
Heavy Mud 146' to 30'
10 Sacks Cement 30' to surface
Welded Plate on top of surface

STATE CORPORATION COMMISSION
10-11-58
OCT 11 1958
CONSERVATION DIVISION
WICHITA, KANSAS

(If additional description is necessary, use BACK of this sheet)
Name of Plugging Contractor Smith & Smith Casing Pullers
Address Duncan, Oklahoma

STATE OF Kansas, COUNTY OF Sedgwick, ss.
M. C. Harrell (employee of owner) or (owner or operator) of the above-described well, being first duly sworn on oath, says: That I have knowledge of the facts, statements, and matters herein contained and the log of the above-described well as filed and that the same are true and correct. So help me God.

(Signature) M. C. Harrell
614 Bitting Building, Wichita, Kansas
(Address)

SUBSCRIBED AND SWORN TO before me this 10th day of October 19 58
H. Howard Kistler
Notary Public.

My commission expires Sept. 20, 1960

PLUGGING
FILE SEC. 15 T. 31 R. 9W
BOOK PAGE 133 LINE 19

The Texas Company
Tulsa, Oklahoma

Tulsa, Oklahoma
October 21, 1957

CONTRACTOR: Stickle Drilling Company
Drilling Commenced: September 29, 1957
Drilling Completed: October 17, 1957

Walter Miller #1 Ctr.
SW NW Sec. 15-13S-9W,
Harper County, Kansas.

DRILLERS LOG

Depth Figure Indicate Base of Formation:

Sand	110
Red Bed & Shells	190
Sand	285
Red Bed & Shale	358
Shale	1340
Shale Shells & Anhydrite	1565
Lime & Shale	1675
Lime	1805
Lime & Shale	2340
Shale & Lime	2920
Lime & Shale	3170
Lime	3225
Lime & Shale	3560
Sandy Shale	3676
Lime	3905
Lime & Shale	3945
Lime	4027
Lime & Shale	4080
Lime	4162
Lime & Shale	4191
Lime	4252
Lime & Shale	4290
Lime	4350
Lime & Shale	4407
Chat	4415
Lime	4420
Chat	4441 TD

NOTARY PUBLIC
STATE OF KANSAS COMMISSION

OCT 21 1957

I, Frank E. Stickle, hereby certify the above to be a true and complete Drillers Log of The Texas Company's Walter Miller #1 Ctr. SW NW Section 15-13S-9W, Harper County, Kansas.

Frank E. Stickle
Frank E. Stickle

Lelaine T. Bombardier
Notary Public

February 13, 1960
My Commission Expires

PLUGGING
FILE SEC. 15 T. 31 R. 9W
BOOK PAGE 133 LINE 19

THE TEXAS COMPANY—LOG OF WELL OKLAHOMA DIVISION

640 ACRES
M

INDICATE EXACT WELL LOCATION &
LEASE BOUNDARY WITHIN SECTION

WELL Walter Miller #1 L. D. FILE NO. 127126

LOC. Center SW NW SEC. 15 TWP. 31S RGE. 9W

660' from S & W Lines of NW/4

DIST. Kansas CO.-PARISH Harper STATE Kansas

COMM. DRLG. 9-29-57 COMP. DRLG. 10-17-57 DAYS DRLG. 19

ROT. FROM 0 TO 4441' CABLE FROM - TO -

CONTR. OR CO. RIG NO. Stickle Drilling Co. T. D. DRILLED 4441'
HF-1643

COMP. T. D. 4401' PETD ZERO ELEV. KB-1646 GRD. ELEV. 1637 CEG. FLG. ELEV.

DATE OF FIRST PROD. DRY OFFICIAL COMP. DATE 11-16-57

LOGS RUN Schlumberger Induction Log and Gamma Ray-Neutron Log

CASING RECORD

SIZE INCHES	DEPTH FEET	WEIGHT #/FT.	GRADE	RANGE	REMARKS—QUAN. CMT., TEMP. SURV., ETC.
2-5/8	356'	23#			360' (9 jts) SW new casing, cemented with 400 sacks regular Dewey cement, 2% CC, cement circulated.
5-1/2	4440'	14#	H-40 & J-55		426' (13 jts) J-55 & 4020' (124 jts) H-40 new casing, cemented with 100 sacks Foxmix & 200 gallons of cement. Top of cement in annulus 3750'

COMPLETION DATA

FORMATION				
DATE OF TEST				
BIRTH OF PROD. INTERVAL				
INITIAL PRODUCTION:				
OIL - BPD				
GAS - MCF				
WATER - BPD				
GOR				
BHP - PSI				
CORRECTED API GRAVITY				
PRODUCING CONDITIONS				
ARTIFICIAL STIMULATION				

375 per. ft. - D.W. prod D.P. 675.00
D.W. without D.P. 375.00 - W.T. 280.00 REMARKS

PLUGGING
FILE SEC 15 T 31 R 9W
BOOK PAGE 133 LINE 19

WELL Walter Miller #1 FIELD Spivey Grabs Pool AREA East Kansas