


WELL PLUGGING RECORD

Give All Information Completely
Make Required Affidavit
Mail or Deliver Report to:
Conservation Division
State Corporation Commission
211 No. Broadway
Wichita, Kansas

Harper County. Sec. 3 Twp. 32 Rge. 6 (~~E~~) W (W)
Location as "NE/CNWxSWx" or footage from lines. NW NW NE
Lease Owner Petroleum, Inc.
Lease Name Zollars Well No. 1
Office Address Route 2, Great Bend, Kansas
Character of Well (completed as Oil, Gas or Dry Hole) Dry hole
Date well completed May 22 19 57
Application for plugging filed May 22 19 57
Application for plugging approved May 22 19 57
Plugging commenced May 22 19 57
Plugging completed May 23 19 57
Reason for abandonment of well or producing formation No Producing zones

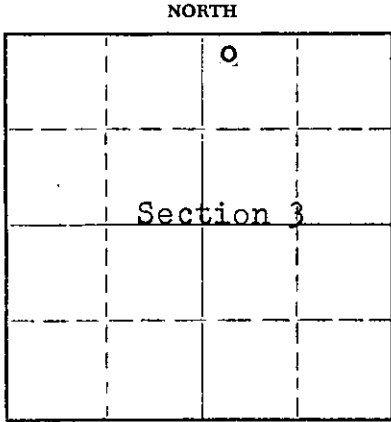

Locate well correctly on above Section Plat

If a producing well is abandoned, date of last production None 19
Was permission obtained from the Conservation Division or its agents before plugging was commenced? Yes

Name of Conservation Agent who supervised plugging of this well M. A. Rives Pratt, Kansas
Producing formation ---- Depth to top -- Bottom -- Total Depth of Well 4890 Feet
Show depth and thickness of all water, oil and gas formations.

OIL, GAS OR WATER RECORDS

CASING RECORD

FORMATION	CONTENT	FROM	TO	SIZE	PUT IN	PULLED OUT
				8 5/8"	248'	None

Describe in detail the manner in which the well was plugged, indicating where the mud fluid was placed and the method or methods used in introducing it into the hole. If cement or other plugs were used, state the character of same and depth placed, from feet to feet for each plug set.

Mud up with heavy mud to 245', pushed down 1/3 sack hulls to 245' followed by wooden plug. Placed 20 sacks cement through drill pipe on to plug. Mud up to 35' and place 1/3 sack hulls at 35' followed by wooden plug and 10 sacks cement to base of well cellar.

RECEIVED
STATE CORPORATION COMMISSION
5-29-57
MAY 29 1957

CONSERVATION DIVISION

(If additional description is necessary, use BACK of this sheet)
Name of Plugging Contractor Garvey Drilling Company
Address Route 2, Great Bend, Kansas

STATE OF KANSAS, COUNTY OF BARTON, ss.
Don Searle (employee of owner) or (owner or operator) of the above-described well, being first duly sworn on oath, says: That I have knowledge of the facts, statements, and matters herein contained and the log of the above-described well as filed and that the same are true and correct. So help me God.

(Signature) Don Searle
Route 2, Great Bend, Kansas (Address)

SUBSCRIBED AND SWORN TO before me this 28th day of May, 19 57

My commission expires July 11, 1960

Edith Brown
Notary Public.

PLUGGING
FILE SEC. 3 T. 32 6W
BOOK PAGE 15 LINE 16

WELL LOG

COMPANY **PETROLEUM, INCORPORATED**

SEC. 3 T. 32S. R. 6W

FARM **ZOLLARS** NO. **1**

LOC. **NW, NW, NE**


TOTAL DEPTH **4890'**

COUNTY **Harper Co., Kansas**

COMM. **May 4, 1957**

COMP. **May 22, 1957**

CONTRACTOR **GARVEY DRILLING COMPANY**

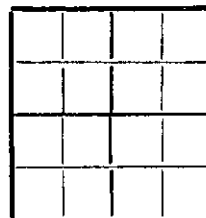

CASING **8 5/8" @ 248' W/200 sax.**

ELEVATION **1387' DF**

PRODUCTION **D & A**

FIGURES INDICATE BOTTOM OF FORMATIONS

30	Sand & clay
38	Gravel
95	Shale
X 500	Red rock
865	Shale
900	Anhydrite
1010	Shale
1200	Lime & shale
1370	Lime
2905	Shale & lime
3055	Shale & sand
3160	Shale
3275	Shale & lime
3490	Sand & shale W/lime streaks
3535	Sand
3585	Lime & shale
3650	Sandy shale, lime & shells
3725	Lime & shale
4065	Lime
4113	Lime & shale
4177	Lime
4217	Shale & lime
4288	Shale & sandy lime
4310	Chert & shale
4321	Chert
4370	Shale, lime & chert
4385	Shale & chert
4559	Lime & chert
4587	Chert
4665	Shale & lime
4710	Shale
4718	Sand
4838	Sand & shale
4890	Lime
4890	T. D.

RECEIVED
STATE CORPORATION COMMISSION

MAY 21 1957

DIVISION
KANSAS

State of KANSAS }
County of BARTON } ss:

PLUGGING

FILE SEC 3 T. 32 R. 6W

BOOK PAGE 15 LINE 16

I, Verne A. Morris of Garvey Drilling Co.

upon oath state that the above and foregoing is a true and correct copy of the log of the #1 Zollars well

Verne A. Morris

Subscribed and sworn to before me this 27th day of May 19 57

My Commission Expires: July 11, 1960

L. D. Brown
NOTARY PUBLIC