


WELL PLUGGING RECORD

Give All Information Completely  
Make Required Affidavit  
Mail or Deliver Report to:  
Conservation Division  
State Corporation Commission  
212 No. Market  
Wichita, Kansas

NORTH

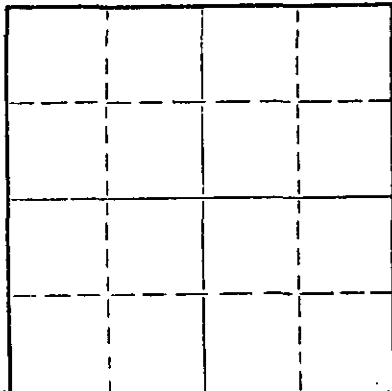

Locate well correctly on above  
Section Plat

Harper County. Sec. 1 Twp. 32S Rge. (E) 6 (W)  
Location as "NE/CNWSW" or footage from lines NW NE NE  
Lease Owner Circle Oil Company, Inc.  
Lease Name McINTOSH Well No. 1  
Office Address 500 Bitting Building, Wichita, Kansas 67202  
Character of Well (completed as Oil, Gas or Dry Hole) Dry Hole  
Date well completed November 17, 1967  
Application for plugging filed 19  
Application for plugging approved 19  
Plugging commenced November 17, 1967  
Plugging completed November 17, 1967  
Reason for abandonment of well or producing formation Dry Hole

If a producing well is abandoned, date of last production 19  
Was permission obtained from the Conservation Division or its agents before plugging was commenced? Yes (Archie Elving)

Name of Conservation Agent who supervised plugging of this well  
Producing formation Depth to top Bottom Total Depth of Well 4694 Feet  
Show depth and thickness of all water, oil and gas formations.

OIL, GAS OR WATER RECORDS

CASING RECORD

FORMATION	CONTENT	FROM	TO	SIZE	PUT IN	PULLED OUT
	Surface	0	248'	8-5/8"	11/6/67	----
	Casing					

Describe in detail the manner in which the well was plugged, indicating where the mud fluid was placed and the method or methods used in introducing it into the hole. If cement or other plugs were used, state the character of same and depth placed, from feet to feet for each plug set.

Heavy Mud from Total Depth to 200 Feet;  
Hull Plug & Plug and 25 sack Cement thru  
the Drill Pipe; Mud to 40 Feet; 1/2 sack  
Hulls & Plug bridged with Kelly and 10  
sacks Cement to Base of Cellar; 2 sacks  
Cement in Rat Hole. Job completed @ 9:30 A.M.

RECEIVED  
STATE CORPORATION COMMISSION  
MAY 21 1967  
CONSERVATION DIVISION

(If additional description is necessary, use BACK of this sheet)

Name of Plugging Contractor Sage Drilling Co.  
Address 500 Bitting Building, Wichita, Kansas

STATE OF KANSAS, COUNTY OF SEDGWICK, ss.  
Lawrence F. Gray (employee of owner) or (owner or operator) of the above-described well, being first duly sworn on oath, says: That I have knowledge of the facts, statements, and matters herein contained and the log of the above-described well as filed and that the same are true and correct. So help me God.

(Signature) Lawrence F. Gray  
500 Bitting Building, Wichita, Kansas (Address)

SUBSCRIBED AND SWORN to before me this 20th day of November 1967

Louise K. Whitted  
Notary Public.

My commission expires November 26, 1970.

DRILLERS LOG

McINTOSH NO. 1

CASING RECORD:           COMPANY:     Circle Oil Company     DESCRIPTION:  
8-5/8" @ 248'           CONTRACTOR: Sage Drilling Co.     NW NE NE  
w/200 sax cement   Sec. 1-32S-6W  
   Harper County, Kansas  
TOTAL DEPTH:            COMMENCED:   November 6, 1967           ELEVATION: 1365KB  
4694'                    COMPLETED:  November 17, 1967

<u>FORMATION</u>	<u>FROM</u>	<u>TO</u>	<u>REMARKS</u>
Red Bed & Shale	0	190	
Shale	190	249	
Red Bed & Shale	249	960	
Shale & Lime	960	1745	
Lime & Shale	1745	2010	
Shale & Lime	2010	2410	
Lime & Shale	2410	2649	
Shale & Lime	2649	3105	
Lime & Shale	3105	3030	
Sand, Lime & Shale	3030	3670	
Shale & Lime	3670	3740	
Lime & Shale	3740	3865	
Shale & Lime	3865	3970	
Lime & Shale	3970	4039	
Lime, Shale & Chert	4039	4116	
Shale	4116	4218	
Lime, Shale & Chert	4218	4275	
Mississippi Lime	4275	4365	
Mississippi Chert & Lime	4365	4576	
Shale	4576	4688	
Simpson Sand	4688	4694	D&A

RECEIVED  
STATE CORPORATION COMMISSION  
NOV 21 1967  
CONSERVATION DIVISION  
Wichita, Kansas

I certify that this is a true and correct copy of the above log to the best of my knowledge.

SAGE DRILLING CO., INC.

By Lawrence F. Gray  
Lawrence F. Gray

Subscribed and sworn to before me this 20th day of November, 1967.

Louise K. Whitted  
Louise K. Whitted, Notary Public

My commission expires:  
November 26, 1970.