

STATE OF KANSAS
STATE CORPORATION COMMISSION


WELL PLUGGING RECORD

Give All Information Completely
Make Required Affidavit
Mail or Deliver Report to:
Conservation Division
State Corporation Commission
800 Bitting Building
Wichita, Kansas

HARPER County, Sec. 2 Twp. 32S Rge. 6 XXX (W)

Location as "NE/CNW/SW" or footage from lines. NE NE NW
Lease Owner Beardmore Drilling Company
Lease Name Olivier Well No. 1
Office Address 603 Petroleum Building, Wichita 2, Kansas
Character of Well (completed as Oil, Gas or Dry Hole) dry hole
Date well completed November 22 19 53
Application for plugging filed November 22w 19 53
Application for plugging approved November 22 19 53
Plugging commenced November 22 19 53
Plugging completed November 22 19 53
Reason for abandonment of well or producing formation dry hole

NORTH

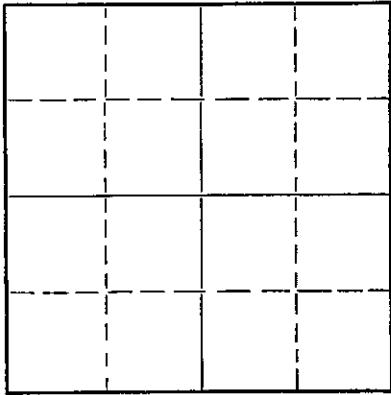

Locate well correctly on above
Section Plat

If a producing well is abandoned, date of last production _____ 19____
Was permission obtained from the Conservation Division or its agents before plugging was commenced? yes

Name of Conservation Agent who supervised plugging of this well Ruel Durkee
Producing formation _____ Depth to top _____ Bottom _____ Total Depth of Well 4885 Feet
Show depth and thickness of all water, oil and gas formations.

OIL, GAS OR WATER RECORDS

CASING RECORD

FORMATION	CONTENT	FROM	TO	SIZE	PUT IN	PULLED OUT
Red Bed and Shale		0	180	8-5/8"	180	-0-

Describe in detail the manner in which the well was plugged, indicating where the mud fluid was placed and the method or methods used in introducing it into the hole. If cement or other plugs were used, state the character of same and depth placed, from top feet to bottom feet for each plug set.

Heavy Mud from 180' to 4885'

Wood Plug @ 180'

15 Sacks Cement 135' to 180'

Heavy Mud from 35' to 135'

Wood Plug @ 35'

10 Sacks Cement from Surface to 35'

(If additional description is necessary, use BACK of this sheet)

Name of Plugging Contractor Beardmore Drilling Company
Address 603 Petroleum Building, Wichita 2, Kansas

STATE OF KANSAS, COUNTY OF SEDGWICK, ss.
I, Heber Beardmore, (employee of owner) or (owner or operator) of the above-described well, being first duly sworn on oath, says: That I have knowledge of the facts, statements, and matters herein contained and the log of the above-described well as filed and that the same are true and correct. So help me God.

(Signature) *Heber Beardmore*
603 Petroleum Bldg., Wichita 2, Kansas
(Address)

SUBSCRIBED AND SWORN to before me this 30th day of November, 1953

Leonard P. Tolle
Notary Public.

My commission expires January 28, 1956

24-7368-S 3-53-20M

PLUGGING
FILE SEC-2 T-32 R-60
BOOK PAGE 115 LINE 8

RECEIVED
STATE CORPORATION COMMISSION
DEC 3 X 1953
CONSERVATION
Wichita

OLIVIER NO. 1

NE NE NW
Section 2-32S-6W
Harper County, Kansas

Drilled for: Beardmore and O. A. Sutton
Drilled by: Beardmore Drilling Company

Casing Record:

180' 8-5/8" w/110 Sacks

Drilling Commenced: November 4, 1953
Drilling Completed: November 22, 1953

Elevation: 1384 KB
1381 DF

<u>FORMATION</u>	<u>DEPTH</u>
Cellar	5
Clay	20
Red Bed and Shale	180
Shale - Shells	980
Anhydrite	995
Shale - Shells	1235
Shale - Lime	1465
Lime - Shale	1635
Lime Broken	1785
Lime	2000
Lime - Shale	2245
Shale - Lime	3040
Lime - Shale	3130
Shale - Lime	3250
Lime - Shale	3340
Shale - Sand	3490
Shale - Lime	3555
Lime - Shale	3665
Lime	4330
Lime - Chert	4370
Lime	4560
Lime - Shale	4610
Shale	4635
Shale - Lime	4675
Shale - Lime - Sand	4690
Cored	4705
Sand	4725
Sand - Shale	4775
Shale - Lime	4835
Lime	4885 T. D.

D & A

TOPS:

Stalnaker Sand	3384
Kansas City	3650
Mississippi	4266
Simpson	4689
Arbuckle	4829

DST #1 - 4280-4299 - Recovered gas to the surface in 59 minutes. Open 1 hour. 55' gas cut mud, 120' oil cut mud, 30' oil cut water, 30' water. BHP 1356, IF 32 FF 78.

Cored 4690-4705 - Full recovered, very white dense sand, probably carrying water, no show of oil.

RECEIVED
STATE CORPORATION COMMISSION

STATE OF KANSAS
COUNTY OF SEDGWICK ^{SS}

DEC 3 X 1953
CONSERVATION DIVISION
Wichita, Kansas

I, the undersigned, being duly sworn on oath state that the above and within statement is a true and correct record and log of the well drilled on the location above-described, to the best of my knowledge and belief.

Subscribed and Sworn to before me this 30th day of November, 1953.
My Commission Expires: January 28, 1956

Robert Beardmore
Leonard P. Tolle Notary Public

PLUGGING
FILE SEC 2 T 32 R 6W
BOOK PAGE 145 LINE 8