

**Strike out upper line
when reporting plug-
ging off formations.**

NORTH

○			

Locate well correctly on above
Section Plat

Wilson County. Sec. 9 Twp. 28 Rge. 15 (E) (W)

Location as "NE $\frac{1}{4}$ NW $\frac{1}{4}$ SW $\frac{1}{4}$ " or footage from lines SW of NW

Lease Owner N.C.Dunn and O.E.Lewis, Arkansas City, Kans.

Lease Name Young Well No. 1

Office Address Arkansas City, Kans. Ph.1617.

Character of Well (Completed as Oil, Gas or Dry Hole) dry hole

Date, well completed. Nov.8, 1937. 193

Application for plugging filed. Nov.8, 1937 193

Application for plugging approved. Nov.8, 1937. 193

Plugging Commenced. Nov.8, 1937 193

Plugging Completed. Nov.9, 1937. 193

Reason for abandonment of well or producing formation dry hole

If a producing well is abandoned, date of last production. 193

Was permission obtained from the Conservation Division or its agents before plugging was commenced?


Name of Conservation Agent who supervised plugging of this well..... R. L. Brinegar.....
Producing formation..... none..... Depth to top..... Bottom..... Total Depth of Well..... 1082..... Feet.....
Show depth and thickness of all water, oil and gas formations.
OIL, GAS OR WATER RECORDS..... CASING RECORD.....

[illegible]

Describe in detail the manner in which the well was plugged, indicating where the mud fluid was placed and the method or methods used in introducing it into the hole. If cement or other plugs were used, state the character of same and depth placed, from.....feet tofeet for each plug set.

Filled up from 1082 to 830' with sand pumpings.

Bridged at 50' with 10' of stone and filled to surface with sand pumpings.

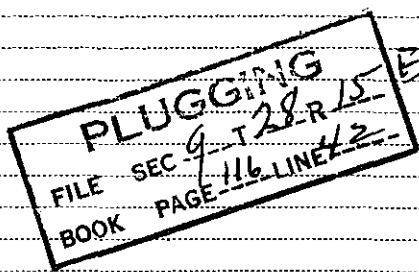

Copy of Log was sent in

(If additional description is necessary, use BACK of this sheet)

Correspondence regarding this well should be addressed to N. C. Dunn, Arkansas City, Kans.
Address.....

STATE OF KANSAS, COUNTY OF _____, ss.

.....N. G. Dunn..... (employee of owner) or (owner or operator) of the above-described well,
being first duly sworn on oath, says: That I have knowledge of the facts, statements, and matters herein contained and the log of the above-described
well as filed and that the same are true and correct. So help me God.

(Signature)

sign here

(Address

SUBSCRIBED AND SWORN to before me this 13 day of NOV 13 1937, 1937.

My Commission Expires Oct. 11, 1939

My commission expires.

17-932 9-37-5M

NOV 14 1937

H.C.DUNN & O.H.LEWIS-OPERATORS.
 YOUNG #1 SW of NW Sec.9, Twp.28, R-15. Wilson County, Kansas.
 DRY HOLE.

Casing record.

soil and clay	28		
Gravel	30	8 $\frac{3}{4}$ "	33
shale	118	6 $\frac{1}{2}$ "	536'
lime	146		
shale	180		
lime	228		
shale	289		
lime	297		
shale	316		
lime W-350'	398		
dark shale	402		
lime	412		
shale	441		
lime	448		
dark shale	458		
lime	485		
shale	494		
lime	530		
dark shale	557		
lime	560		
shale	720		
lime	724		
shale	728		
lime	750		
shale	780		
lime	798		
shale	804		
lime	810		
shale	830		
sand	848		
shale	1002		
sandy shale	1030		
dark shale	1072		
sand water	1082	T.D.	

Completed Nov.9,1937.

