


Give All Information Completely
Make Required Affidavit
Mail or Deliver Report to:
Conservation Division
State Corporation Commission
212 No. Market
Wichita, Kansas

Clark County, Sec. 33 Twp. 32 Rge. (E) 21 (W)
Location as "NE/CNWxSWx" or footage from lines C NW/4
Lease Owner J. M. Huber Corporation
Lease Name YORK Well No. 1
Office Address P. O. Box 831, Borger, Texas 79007
Character of Well (completed as Oil, Gas or Dry Hole) Oil
Date well completed December 30 1965
Application for plugging filed November 7 1967
Application for plugging approved November 8 1967
Plugging commenced January 2 1968
Plugging completed January 2 1968
Reason for abandonment of well or producing formation Production depleted -
uneconomical to produce.
If a producing well is abandoned, date of last production October 19 67
Was permission obtained from the Conservation Division or its agents before plugging was com-
menced? Yes

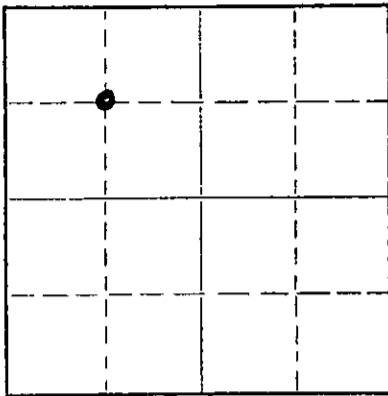

Locate well correctly on above Section Plat

Name of Conservation Agent who supervised plugging of this well Ed Eyes
Producing formation Morrow Depth to top 5314 Bottom 5348 Total Depth of Well 5500 Feet
Show depth and thickness of all water, oil and gas formations.

OIL, GAS OR WATER RECORDS

CASING RECORD

| FORMATION | CONTENT | FROM | TO | SIZE | PUT IN | PULLED OUT |
|-----------|---------|------|------|--------|--------|------------|
| None | | | | 8-5/8" | 712' | None |
| Morrow | | 5314 | 5348 | 4-1/2" | 5393' | 3530' |
| | | | | | | |
| | | | | | | |
| | | | | | | |

Describe in detail the manner in which the well was plugged, indicating where the mud fluid was placed and the method or methods used in introducing it into the hole. If cement or other plugs were used, state the character of same and depth placed, from _____ feet to _____ feet for each plug set.

20 sacks cement 5348-5124; mud laden fluid 5124-700'; spot 35 sacks cement 600-700'; mud laden fluid to 35'; 10 sacks cement 35' to surface.

RECEIVED
STATE CORPORATION COMMISSION
JAN 22 1968
CONSERVATION DIVISION
Wichita, Kansas

(If additional description is necessary, use BACK of this sheet)
Name of Plugging Contractor Sargeant Casing Pullers
Address Liberal, Kansas

STATE OF TEXAS COUNTY OF HUTCHINSON, ss.
Vaden Fowler (employee of owner) or (owner or operator) of the above-described well, being first duly sworn on oath, says: That I have knowledge of the facts, statements, and matters herein contained and the log of the above-described well as filed and that the same are true and correct. So help me God.

(Signature) Vaden Fowler
P. O. Box 831, Borger, Texas 79007
(Address)

SUBSCRIBED AND SWORN TO before me this 19 th day of January, 19 68

Meryle M. Chambless
Notary Public
in & for Hutchinson County, Texas

My commission expires June 1st, 1969

GABBERT-JONES, INC.
 WICHITA, KANSAS
 DRILLERS' WELL LOG

RECEIVED
 CORPORATION COMMISSION

NOV 8 1967

CONSERVATION DIVISION
 Wichita, Kansas

YORK #1
 C NW $\frac{1}{4}$ SECTION 33-32S-21W
 CLARK COUNTY, KANSAS

COMMENCED: DECEMBER 12, 1965
 COMPLETED: DECEMBER 30, 1965

OPERATOR - J. M. HUBER CORPORATION

| DEPTH | FORMATION | REMARKS |
|-------|-----------|--|
| FROM | To | |
| 0 | 190 | RED BED |
| 190 | 713 | RED BED AND SHELLS RAN 18 JOINTS OF 8-5/8" CASING, SET @ 712' w/525 SACKS CEMENT. |
| 713 | 870 | RED BED AND SHELLS |
| 870 | 1985 | RED BED AND SHALE |
| 1985 | 2300 | SHALE AND SHELLS |
| 2300 | 2930 | SHALE AND LIME |
| 2930 | 3095 | LIME |
| 3095 | 3795 | SHALE AND LIME |
| 3795 | 4100 | LIME |
| 4100 | 4365 | LIME AND SHALE |
| 4365 | 5188 | LIME |
| 5188 | 5330 | LIME AND SHALE |
| 5330 | 5500 | LIME |
| 5500 | TD | RAN 165 JOINTS OF 4 $\frac{1}{2}$ " CASING, SET @ 5393' w/150 SACKS CEMENT. |


I, E. E. HALL, CERTIFY THIS IS A CORRECT COPY OF THE DRILLERS' LOG FOR THE WELL DRILLED IN THE C NW $\frac{1}{4}$ SECTION 33-32S-21W, CLARK COUNTY, KANSAS, TO THE BEST OF MY KNOWLEDGE AND BELIEF.


 E. E. HALL

STATE OF KANSAS)
) SS
 COUNTY OF SEDGWICK)

BEFORE ME, THE UNDERSIGNED, A NOTARY PUBLIC WITHIN AND FOR SAID COUNTY AND STATE, ON THIS 31ST DAY OF DECEMBER, 1965, PERSONALLY APPEARED E. E. HALL, TO ME PERSONALLY KNOWN TO BE THE IDENTICAL PERSON WHO EXECUTED THE WITHIN AND FOREGOING INSTRUMENT AND ACKNOWLEDGED TO ME THAT HE EXECUTED THE SAME AS HIS FREE AND VOLUNTARY ACT AND DEED FOR THE USES AND PURPOSES THEREIN SET FORTH.

IN WITNESS WHEREOF, I HAVE HEREUNTO SET MY HAND AND OFFICIAL SEAL THE DAY AND YEAR LAST ABOVE WRITTEN.

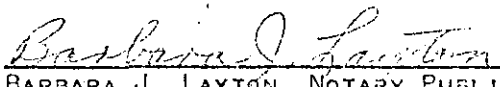
 BARBARA J. LAYTON, NOTARY PUBLIC

MY COMMISSION EXPIRES FEBRUARY 1, 1968.