


STATE OF KANSAS
STATE CORPORATION COMMISSION

WELL PLUGGING RECORD

Give All Information Completely
Make Required Affidavit
Mail or Deliver Report to:
Conservation Division
State Corporation Commission
800 Biting Building
Wichita, Kansas

OR
FORMATION PLUGGING RECORD

Strike out upper line
when reporting plugging
off formations.

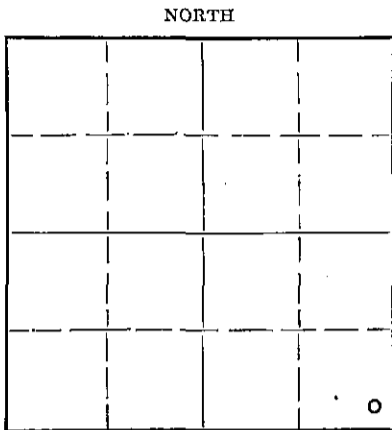

Locate well correctly on above
Section Plat

Harper County. Sec. 28 Twp. 31 Rge. 9 (E) 9 (W)
Location as "NE 1/4 NW 1/4 SW 1/4" or footage from lines SE SE SE
Lease Owner Earl F. Wakefield
Lease Name Muir Well No. 1
Office Address 307 Union National Bank Building, Wichita, Kans.
Character of Well (completed as Oil, Gas or Dry Hole) Dry Hole
Date well completed December 24 1950
Application for plugging filed December 24 1950
Application for plugging approved December 24 1950
Plugging commenced December 24 1950
Plugging completed December 24 1950
Reason for abandonment of well or producing formation

If a producing well is abandoned, date of last production 19
Was permission obtained from the Conservation Division or its agents before plugging was commenced? Yes

Name of Conservation Agent who supervised plugging of this well J. P. Roberts
Producing formation Depth to top Bottom Total Depth of Well 1505 Feet
Show depth and thickness of all water, oil and gas formations.

OIL, GAS OR WATER RECORDS

CASING RECORD

Formation	Content	From	To	Size	Put In	Pulled Out
				8 5/8"	194'	

Describe in detail the manner in which the well was plugged, indicating where the mud fluid was placed and the method or methods used in introducing it into the hole. If cement or other plugs were used, state the character of same and depth placed, from feet to feet for each plug set.

Filled hole with mud to 194 feet, cemented with 20 sacks cement,
filled hole with mud to 25 feet, cemented with 5 sacks cement to
top of hole.

REC-
STATE CORPORATION COMMISSION
JAN 13 1951 1-3-51
CONSERVATION DIVISION
Wichita, Kansas

(If additional description is necessary, use BACK of this sheet)

Correspondence regarding this well should be addressed to Earl F. Wakefield
Address 307 Union National Bank Building
Wichita, Kansas

STATE OF Kansas, COUNTY OF Sedgwick, ss.
Earl F. Wakefield (employee of owner) or (owner) of the above-described well,
being first duly sworn on oath, says: That I have knowledge of the facts, statements, and matters herein contained and the log of the above-described well as filed and that the same are true and correct. So help me God.

(Signature) Earl F. Wakefield

(Address)

SUBSCRIBED AND SWORN to before me this 2nd day of January, 1951

E. E. Gaffney
Notary Public.

My commission expires 12-23-54

PLUGGING
FILE SEC-28 T-31 R-9W
BOOK PAGE 51 LINE 3

Muir #1

Owners: Earl F. Wakefield et al
Contractor: Earl F. Wakefield
Comm: 12-1-50, Comp: 12-24-50

SE SE SE 28-31-9W
Harper County, Kansas
Casing: 194' of 8 5/8"

Elevation 1617

Surface	194
Red Bed	315
Shale & sand	835
Shale & shells	1045
Sand & sandy shale	1070
Shale & shells	1220
Shale	1400
Shale & shells	1470
Lime & shale	1585
Lime	1680
Shale & Lime streaks	1830
Lime	1900
Lime & shale	1945
Lime	1990
Lime & shale	2265
Lime	2290
Shale & lime	2475
Shale	2550
Shale & lime streaks	2665
Shale & lime	3075
Shale	3095
Shale & sandy lime	3120
Shale & lime	3270
Sandy Lime & shale	3355
Lime	3378
Shale & lime	3580
Shale	3633
Sand	3670
Lime	3718
Sandy lime	3738
Lime	3936
Lime & shale	3973
Sand & sandy lime	4002
Lime	4050
Lime & shale	4123
Lime	4166
Lime & shale	4309
Lime	4336
Shale & lime streaks	4387
Shale	4408
Lime	4425
Chert	4480
Lime	4505
T. D.	4505

Tops:
Miss. Lime 4408

STATE OF KANSAS)
) SS
COUNTY OF SEDGWICK)

STATE OF KANSAS
JAN 3 1951
COUNTY OF SEDGWICK

I hereby certify that the above is a true and correct copy of the log of the Muir #1 well located SE SE SE 28-31-9W, Harper County, Kansas.

PLUGGING
WELL NO. 28-31-9W
DATE 5/1/51

Earl F. Wakefield

Subscribed and sworn to before me this 2nd day of January, 1951.

My Commission Expires: 12-23-54

E. James Gaffney