

15-077-20359-00-00

FORM CP-4

STATE OF KANSAS
STATE CORPORATION COMMISSION
CONSERVATION DIVISION
P. O. BOX 17027
WICHITA, KANSAS 67217

WELL PLUGGING RECORD

Harper

County, Sec 7, Twp 32S, R. 5W (K) (W)

Location as "NE/CNW/SE" or footage from lines approx. C/W₂ SW₄ SW₄

Lease Owner Okmar Oil Co.

Lease Name Drouhard "A" Well No. 1

Office Address

Character of Well (completed as Oil, Gas or Dry Hole) Dry Hole

Date well completed May 6, 1976 19

Application for plugging filed May 5, 1976 19

Application for plugging approved May 5, 1976 19


Plugging commenced May 6, 1976 19

Plugging completed May 6, 1976 19

Reason for abandonment of well or producing formation dry & Abandoned

If a producing well is abandoned, date of last production 19

Was permission obtained from the Conservation Division or its agents before plugging was commenced? yes

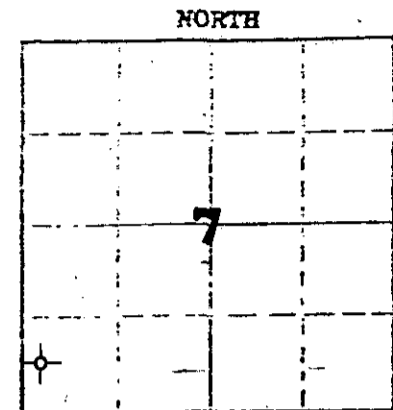

Locate well correctly on above Section Map

Name of Conservation Agent who supervised plugging of this well G. R. Biberstein

Producing formation Depth to top Bottom Total Depth of Well 4712

Show depth and thickness of all water, oil and gas formations.

OIL, GAS OR WATER RECORDS

CASING RECORD

FORMATION	CONTENT	FROM	TO	SIZE	PUT IN	PULLED OUT
				8 5/8"	242.75	-0-

Describe in detail the manner in which the well was plugged, indicating where the mud fluid was placed and the method or methods used in introducing it into the hole. If cement or other plugs were used, state the character of same and depth placed, from feet to feet for each plug set.

Plug @ 225' w/35 sx cmt

Plug @ 40' w/15 sx cmt

RECEIVED
STATE CORPORATION COMMISSION
MAY 18 1976
6-18-76
CONSERVATION DIVISION
WICHITA, KANSAS

(If additional description is necessary, use BACK of this sheet)

Name of Plugging Contractor Red Tiger Drilling Co.

Address 1720 KSB&T Bldg., Wichita, Ks. 67202

STATE OF Kansas COUNTY OF Sedgwick

Jean Stocks

(employee of owner) or (owner or operator) of the above-described

well, being first duly sworn on oath, says: That I have knowledge of the facts, statements, and matters herein contained and the log of the above-described well as filed and that the same are true and correct. So help me God.

(Signature)

1720 KSB&T Bldg., Wichita, Ks. 67202

(Address)

Subscribed and sworn to before me this 14th day of May, 1976

My commission expires

D'Ann Drennan
Notary Public



Drillers Log

No. 1 Drouhard "A"

CASING RECORD: 8 5/8" @ 250' w/225 sx cmt
 COMPANY: Okmar Oil Company
 CONTRACTOR: Red Tiger Drilling Company
 COMMENCED: April 19, 1976
 COMPLETED: May 6, 1976
 DESCRIPTION: Aprox. C/W $\frac{1}{2}$ SW $\frac{1}{2}$ SW $\frac{1}{2}$ Sec. 7-T32S-R5W Harper County, Kansas
 TOTAL DEPTH: 4712' ELEVATION: 1338' KB

FORMATION	FROM	TO	REMARKS
Surface Soil	0	35	
Clay & Sand	35	252	
Shale & Shells	252	860	
Lime & Shale	860	1135	
Lime & Shale	1135	1300	
Lime & Shale	1300	1530	
Lime & Shale	1530	1745	
Lime & Shale	1745	1855	
Lime & Shale	1855	2055	
Lime & Shale	2055	2275	
Lime & Shale	2055	2275	
Lime & Shale	2275	2440	
Lime & Shale	2440	2570	
Lime & Shale	2570	2712	
Lime & Shale	2712	2770	
Lime & Shale	2770	2915	
Lime & Shale	2915	3050	
Lime & Shale	3050	3150	
Lime & Shale	3150	3225	
Lime & Shale	3225	3305	
Lime & Shale	3305	3390	
Lime & Shale	3390	3490	
Lime & Shale	3490	3560	
Lime & Shale	3560	3625	
Lime & Shale	3625	3668	
Lime & Shale	3668	3675	
Lime	3675	3745	
Lime & Shale	3745	3815	
Lime & Chert	3815	3840	
Lime & Shale	3840	3950	
Lime & Shale	3950	4015	
Lime & Shale	4015	4095	
Lime & Shale	4095	4175	
Lime & Shale	4175	4260	
Lime & Chert	4260	4322	
Lime & Shale	4322	4390	
Lime & Shale	4390	4495	
Lime & Shale	4495	4575	
Lime & Shale	4575	4634	
Lime & Shale	4634	4685	
Lime & Shale	4685	4710	
Lime & Shale	4710	4712	
RTD	4712	4712	

RECEIVED
STATE CONSERVATION COMMISSION


JUN 18 1976

CONSERVATION DIVISION
Wichita, Kansas

I certify that this is a true and correct copy of the above log to the best of my knowledge.

RED TIGER DRILLING COMPANY

Jean Stocks
Jean Stocks

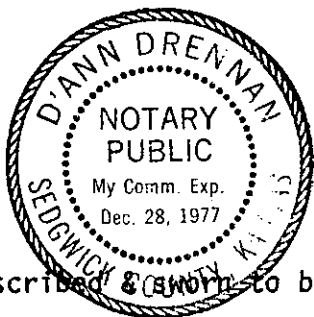

Subscribed & sworn to before me this 14th day of May, 1976.

D'Ann Drennan
Notary Public