


WELL PLUGGING RECORD

Give All Information Completely
Make Required Affidavit
Mail or Deliver Report to:
Conservation Division
State Corporation Commission
800 Bitting Building
Wichita, Kansas

NORTH

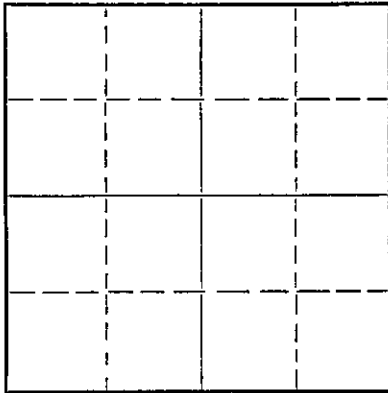

Locate well correctly on above
Section Plat

Harper County. Sec 3 Twp 32 Rge. 48X 5 (W)
Location as "NE/CNW $\frac{1}{4}$ SW $\frac{1}{4}$ " or footage from lines SE NE NW
Lease Owner Sohio Petroleum Company
Lease Name Weede Well No. 1
Office Address P.O. Box 673, Russell, Kansas
Character of Well (completed as Oil, Gas or Dry Hole) Dry
Date well completed 1-7 1953
Application for plugging filed 1-8 1953
Application for plugging approved 1/7/53 Verbal 19
Plugging commenced 1-7 1953
Plugging completed 1-7 1953
Reason for abandonment of well or producing formation Dry hole
If a producing well is abandoned, date of last production 19
Was permission obtained from the Conservation Division or its agents before plugging was commenced? Yes

Name of Conservation Agent who supervised plugging of this well Durkee
Producing formation Depth to top Bottom Total Depth of Well 4825 Feet
Show depth and thickness of all water, oil and gas formations.

OIL, GAS OR WATER RECORDS

CASING RECORD

Formation	Content	From	To	Size	Put In	Pulled Out
Surface		Surface	327	10-3/4	324.81	None

Describe in detail the manner in which the well was plugged, indicating where the mud fluid was placed and the method or methods used in introducing it into the hole. If cement or other plugs were used, state the character of same and depth placed, from feet to feet for each plug set.

Filled w/heavy mud to 250'. Bridged 10-3/4 casing at 250' &
cemented w/20 sax. Filled with heavy mud to 20'. Bridged
hole at 20' and cemented to bottom of cellar w/5 sax.

(If additional description is necessary, use BACK of this sheet)

Name of Plugging Contractor Reserve Drilling Company
Address Wichita, Kansas

STATE OF KANSAS, COUNTY OF RUSSELL, ss.
J. H. Bond (employee of owner) of the above-described well,
being first duly sworn on oath, says: That I have knowledge of the facts, statements, and matters herein contained and the log of the above-described well as filed and that the same are true and correct. So help me God.

(Signature)

J. H. Bond

(Address)

SUBSCRIBED AND SWORN to before me this 9th day of January 19 53

My commission expires

20 April 1956

23-8390-s

6-51-20M

PLUGGING

1-12-53
INFORMATION DIVISION
Wichita, Kansas

WELL LOG

Sohio Petroleum Company

WEEDE No. 1

SE NE NW 3-32S-5W

Harper County


Kansas

Date Commenced 11-22-52

Date Completed 1-7-53

Casing: 10-3/4" @ 310'

<u>Formation</u>	<u>Depth</u>
Surface	30
Red rock and shale	100
Red rock, shale and shells	580
Shale and shells	823
Anhydrite	858
Shale	970
Broken Lime	1030
Shale	1067
Gypsum Rock	1118
Shale and lime shells	1165
Shale and lime	1170
Shale, lime and chert	1182
Shale and lime	1255
Shale	1295
Shale and lime	1660
Shale and lime	1935
Shale and lime shells	1980
Shale and shells	2260
Lime	2300
Lime and shale	2489
Shale and sand	2554
Lime	2566
Lime and shale	2790
Shale and lime shells	2924
Shale and lime	3134
Shale and lime shells	3225
Shale and sand	3280
Lime and shale	3301
Lime	3379
Shale and sand	3493
Shale	3557
Shale and lime shells	3563
Lime	3595
Lime and shale	3650
Lime	3677
Lime and shale	4239
Lime	4256
Lime and shale	4280
Lime, shale and chert	4300
Lime and chert	4335
Lime, shale and chert	4353
Lime and chert	4365
Lime, shale and chert	4440
Lime and shale	4497
Lime and chert	4510
Lime and shale	4522
Cherty lime and shale	4573
Shale	4608
Shale and lime	4636
Shale	4640
T.D.	4825

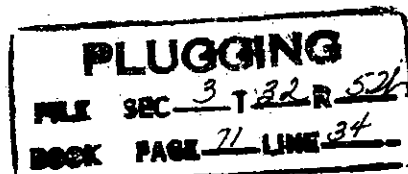

RECEIVED
STATE CORRELATION DIVISION
JAN 2 1953
CONSERVATION DIVISION
Wichita, Kansas

Cored 4640 to 4825 T.D.

STATE OF KANSAS)
COUNTY OF SEDGWICK) SS:

L. C. Hay, of lawful age, deposes and states that the above formations and depths are correct as shown by the daily drilling log of the Weede No. 1 in the SE NE NW of 3-32S-5W, Harper County, Kansas.

Subscribed and sworn to before me this 14th day of January, 1953.

My commission expires Nov. 3, 1956

L. C. Hay
Notary Public