


WELL PLUGGING RECORD

Give All Information Completely
Make Required Affidavit
Mail or Deliver Report to:
Conservation Division
State Corporation Commission
212 North Market, Insurance Bldg.
Wichita, Kansas

HARPER County, Sec. 32 Twp. 31s Rge. 9w (X) (W)

Location as "NE/CNW/SW" or footage from lines SE NW SW
Lease Owner PETROLEUM, INC.
Lease Name MCBRIDE "B" Well No. 1
Office Address ROUTE #2, GREAT BEND, KANSAS
Character of Well (completed as Oil, Gas or Dry Hole) DRY HOLE
Date well completed APRIL 27, 19 61
Application for plugging filed APRIL 27, 19 61
Application for plugging approved APRIL 27, 19 61
Plugging commenced APRIL 27, 19 61
Plugging completed APRIL 27, 19 61
Reason for abandonment of well or producing formation NO PRODUCIBLE ZONES

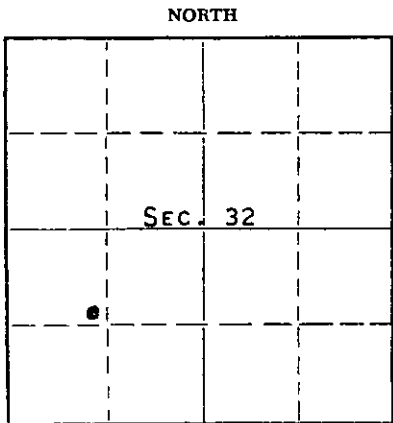

Locate well correctly on above Section Plat

If a producing well is abandoned, date of last production NONE 19
Was permission obtained from the Conservation Division or its agents before plugging was commenced? YES

Name of Conservation Agent who supervised plugging of this well MR. FRED W. HAMPEL
Producing formation ----- Depth to top -- Bottom -- Total Depth of Well L-4460' Feet
Show depth and thickness of all water, oil and gas formations.

OIL, GAS OR WATER RECORDS

CASING RECORD

FORMATION	CONTENT	FROM	TO	SIZE	PUT IN	PULLED OUT
				8 5/8"	244'	NONE

Describe in detail the manner in which the well was plugged, indicating where the mud fluid was placed and the method or methods used in introducing it into the hole. If cement or other plugs were used, state the character of same and depth placed, from _____ feet to _____ feet for each plug set.

MUDDED UP WITH HEAVY MUD TO 240' FOLLOWED BY WOODEN PLUG, AND 1/2 SACK HULLS. PLACED 15 SACKS CEMENT THROUGH DRILL PIPE ON TO HULLS. MUDDED UP WITH HEAVY MUD TO 35' FOLLOWED BY WOODEN PLUG AND 1/2 SACK HULLS. PLACED 10 SACKS CEMENT THROUGH DRILL PIPE ON TO HULLS TO BASE OF WELL CELLAR. PLACED 2 SACKS CEMENT INTO RAT HOLE.

RECEIVED
STATE CORPORATION COMMISSION
5-8-61
MAY 8 1961

CONSERVATION DIVISION
Wichita, Kansas

(If additional description is necessary, use BACK of this sheet)

Name of Plugging Contractor GARVEY DRILLING COMPANY
Address ROUTE #2, GREAT BEND, KANSAS

STATE OF KANSAS, COUNTY OF BARTON, ss.
DON SEARLE (employee of owner) or (owner) of the above-described well, being first duly sworn on oath, says: That I have knowledge of the facts, statements, and matters herein contained and the log of the above-described well as filed and that the same are true and correct. So help me God.

(Signature) Don Searle
ROUTE #2, GREAT BEND, KANSAS
(Address)

SUBSCRIBED AND SWORN TO before me this 5TH day of MAY, 19 61

My commission expires APRIL 14, 1963

Arthur J. Miles
Notary Public.



WELL LOG

COMPANY PETROLEUM, INCORPORATED

SEC. 32 T31S R. 9W

FARM McBRIDE "B" NO. 1

LOC. SE, NW, SW


TOTAL DEPTH 4460'

COUNTY HARPER CO., KANSAS

COMM. April 15, 1961 COMP. April 27, 1961

CONTRACTOR GARVEY DRILLING COMPANY

CASING 8-5/8" @ 244' w/165 sax.

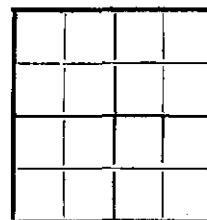

ELEVATION 1551' DF

PRODUCTION D & A

FIGURES INDICATE BOTTOM OF FORMATIONS

188	Surface soil & red bed
252	Shale & shells
450	Red bed
1365	Shale
1645	Shale & lime
1815	Shale
1975	Lime & shale
2975	Shale & lime
3135	Lime & shale
3180	Shale
3475	Shale & lime
3670	Lime & shale
4183	Lime
4379	Lime & shale
4460	Lime
4460	T. D.

RECEIVED
STATE CORPORATION COMMISSION

MAY 8 1961

CONSERVATION DIVISION
Wichita, Kansas

State of KANSAS }
County of BARTON } ss

I, VERNE A. MORRIS of GARVEY DRILLING COMPANY

upon oath state the above and foregoing is a true and correct copy of the log of the #1 McBRIDE "B" well.

Subscribed and sworn to before me this 2nd day of May 1961

My Commission Expires: April 14, 1963

Verne A. Morris
Arthur J. Miles
NOTARY PUBLIC