


WELL PLUGGING RECORD

Give All Information Completely  
Make Required Affidavit  
Mail or Deliver Report to:  
Conservation Division  
State Corporation Commission  
800 Bitting Building  
Wichita, Kansas

Harper County, Sec. 21 Twp. 31 Rge. 9 (E) W (W)

Location as "NE/CNW/SW" or footage from lines NE NE SE  
Lease Owner Mull Drilling Co. Inc.  
Lease Name Muir Well No. 1  
Office Address 6405 E. Kellogg, Wichita, Kansas  
Character of Well (completed as Oil, Gas or Dry Hole) Dry Hole  
Date well completed Dec. 20, 1956 19  
Application for plugging filed Dec. 20, 1956 19  
Application for plugging approved Dec. 20, 1956 19  
Plugging commenced 4:00 P.M. Dec. 20, 1956 19  
Plugging completed 8:00 P.M. Dec. 20, 1956 19  
Reason for abandonment of well or producing formation  
Dry Hole  
If a producing well is abandoned, date of last production \_\_\_\_\_ 19  
Was permission obtained from the Conservation Division or its agents before plugging was commenced? Yes

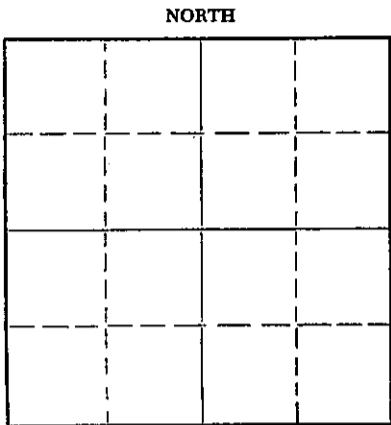

Locate well correctly on above Section Plat

Name of Conservation Agent who supervised plugging of this well Mr. Rives  
Producing formation None Depth to top none Bottom none Total Depth of Well 4560 Feet  
Show depth and thickness of all water, oil and gas formations.

OIL, GAS OR WATER RECORDS

CASING RECORD

| FORMATION | CONTENT | FROM | TO   | SIZE         | PUT IN  | PULLED OUT |
|-----------|---------|------|------|--------------|---------|------------|
| None      |         |      | 160' | 8 5/8 casing | put in. |            |
|           |         |      |      |              |         |            |
|           |         |      |      |              |         |            |
Describe in detail the manner in which the well was plugged, indicating where the mud fluid was placed and the method or methods used in introducing it into the hole. If cement or other plugs were used, state the character of same and depth placed, from 200 feet to \_\_\_\_\_ feet for each plug set.

~~Plug set at 200' with 25 sacks of cement on top. Plug set at 20' with ten sacks cement on top. Hole was filled with heavy rotary mud, plug set at 200' 25 sacks of cement on top, mud on top of cement. Plug set at 20' 10 sacks of cement on top. Surface pipe cut off 4 feet below ground level. Cement was mixed and placed in hole through drill pipe.~~

(If additional description is necessary, use BACK of this sheet)

Name of Plugging Contractor Company tools.  
Address 6405 E. Kellogg, Wichita, Kansas

STATE OF Kansas, COUNTY OF Harper, ss.  
O. C. Arnott (employee of owner) or (owner or operator) of the above-described well, being first duly sworn on oath, says: That I have knowledge of the facts, statements, and matters herein contained and the log of the above-described well as filed and that the same are true and correct. So help me God.

(Signature) [Signature]  
Attica, Kansas (Address)

SUBSCRIBED AND SWORN TO before me this 20 day of December, 19 56

My commission expires Jan. 22, 1957 [Signature] Notary Public.

PLUGGING  
FILE SEC 21 T. 31 R. 9W  
BOOK PAGE 128 LINE 20

RECEIVED  
DEC 27 1956 12-27-56  
CONSERVATION DIVISION  
Wichita, Kansas

ROTARY DRILLERS LOG

COMPANY : Mull Drilling Company, Inc. ROTARY DRILLING COMMENCED: 12-7-56  
Wichita, Kansas

CONTRACTOR : Mull Drilling Company, Inc. ROTARY DRILLING COMPLETED: 12-20-56  
Wichita, Kansas

CASING RECORD : Set 8 5/8" @ 160' cemented with 125 sacks cement. LOCATION: MUIR #1  
NE NE SE of Sec. 21-31-9W  
Harper County, Kansas

(Figures indicate bottom of formation - measurements from top of Rotary Bushing)

|                         |              |
|-------------------------|--------------|
| Sand                    | 100          |
| Red Bed                 | 500          |
| Shale & Shells          | 660          |
| Red Bed, Shale & Shells | 1380         |
| Lime & Shale            | 3954         |
| Lime (Mississippi)      | 4559' R.T.D. |

I hereby certify that this is a true and correct copy of the above log to the best of my knowledge.

MULL DRILLING COMPANY, INC.

BY  JOSEPH B. BRUNGARDT, JR.  
NOTARY PUBLIC

STATE OF KANSAS )  
                          ) SS  
COUNTY OF SEDGWICK )

Subscribed and sworn to before me this 27th day of December, 1956.



Madge N. Miller  
NOTARY PUBLIC

MY COMMISSION EXPIRES: FEBRUARY 24, 1960.

RECEIVED  
STATE CORPORATION COMMISSION  
DEC 28 1956  
CONSERVATION DIVISION  
Wichita, Kansas

PLUGGING

FILE SEC 21 T. 31 R. 9W.  
BOOK PAGE 128 LINE 20