


STATE OF KANSAS
STATE CORPORATION COMMISSION

Give All Information Completely
Make Required Affidavit
Mail or Deliver Report to:
Conservation Division
State Corporation Commission
P. O. Box 17027
Wichita, Kansas 67217
NORTH

WELL PLUGGING RECORD

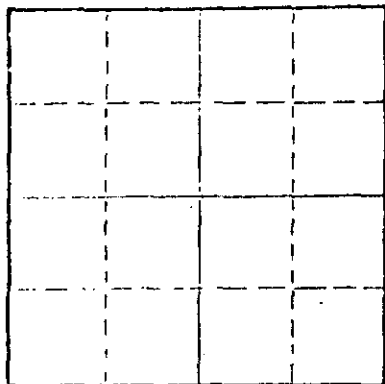

Locate well correctly on above
Section Plat

Harper County, Sec. 20 Twp. 31 R. 9 (E) (W)

Location as "NE/CNW/SE" or footage from lines: C SE NE SE
Lease Owner: McCoy Petroleum Co.
Lease Name: Green Well No. 1
Office Address: 816 Vickers KSB&T Bldg.
Character of Well (completed as Oil, Gas or Dry Hole): Gas
Date well completed: 3-26-1977
Application for plugging filed: 3-26-1977
Application for plugging approved: 3-28-1977
Plugging commenced: 3-30-1977
Plugging completed: 4-4-1977

Reason for abandonment of well or producing formation
If a producing well is abandoned, date of last production: 19
Was permission obtained from the Conservation Division or its agents before plugging was commenced? Yes

Name of Conservation Agent who supervised plugging of this well: Bud Metz
Producing formation: Depth to top: Bottom: Total Depth of Well: 4440 Feet
Show depth and thickness of all water, oil and gas formations.

OIL, GAS OR WATER RECORDS

CASING RECORD

FORMATION	CONTENT	FROM	TO	SIZE	PUT IN	PULLED OUT
				8 5/8	243	None
				4 1/2	4500	1310

Describe in detail the manner in which the well was plugged, indicating where the mud fluid was placed and the method or methods used in introducing it into the hole. If cement or other plugs were used, state the character of same and depth placed, from feet to feet for each plug set.

Plugged back to 1800' - Cement by Allied
Sand from 1800' to 1690'
4 sacks cement from 1690' to 1650'
Ripped pipe at 1310', pulled and layed down.
Wooden Bridge at 210'
Rock from 210' to 200'
4 yards ready mix to surface

RECEIVED
STATE CORPORATION COMMISSION
APR 27 1977
CONSERVATION DIVISION
Wichita, Kansas

Name of Plugging Contractor: Clarke Corporation (If additional description is necessary, use BACK of this sheet)
Address: Box 187, Medicine Lodge, Kansas 67104

STATE OF Kansas COUNTY OF Barber, ss.

(employee of owner) or (owner or operator) of the above-described well, being first duly sworn on oath, says: That I have knowledge of the facts, statements, and matters herein contained and the log of the above-described well as filed and that the same are true and correct. So help me God.

(Signature) Elmer F. Haggard
Medicine Lodge, Kas.
(Address)

Subscribed and Sworn to before me this 8th day of April, 1977

My commission expires April 4, 1978. Jessie Hamilton Notary Public.

WELL LOG
Green # #1
SE NE SE 20-31S-9W
Harper County Kansas

Name Of Operator: McCoy Petroleum Co.
816 Vickers KSB & T Bldg.
Wichita, Kansas 67202

Date Completed: May 6, 1976


<u>FROM</u>	<u>TO</u>	
0	80	Sand
80	1200	Red Bed and shale
1200	3848	Lime and shale
3848	4440	Lime
4440		Total Depth

RECORDED
STATE COMMISSION OF
MAR 3 1977
CONSULTED BY
Wichita, Kansas

STATE OF KANSAS

COUNTY OF BARTON ss

Gary L. Hawk, Secretary of Sweetman Drilling, Inc., being first duly sworn on oath says: That I have knowledge of the facts, statements and matters herein contained and the log of the above described well as filed and that the same are true and correct.

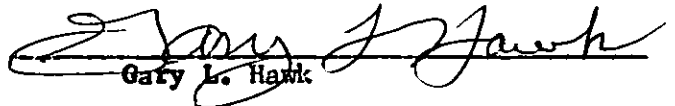
Gary L. Hawk

Subscribed and sworn before me this 14th day of May, 1976.


Notary Public . Barton County

My Commission Expires 7-10-77

