

15-007-00622-0000

STATE OF KANSAS
STATE CORPORATION COMMISSION

Form CP-4


Give All Information Completely
Make Required Affidavit
Mail or Deliver Report to:
Conservation Division
State Corporation Commission
212 No. Market
Wichita, Kansas 67202

WELL PLUGGING RECORD

Barber County, Sec. 30 Twp. 34-S Rge. (E) 14 (W)

Location as "NE/CNW/SE/SW" or footage from lines
Lease Owner APCO Oil Corporation
Lease Name Davis Ranch "C" Well No. 1
Office Address P. O. Box 1841, Oklahoma City, Oklahoma 73101
Character of Well (completed as Oil, Gas or Dry Hole) Gas Well
Date well completed October 8 19 59
Application for plugging filed January 7 19 72
Application for plugging approved January 10 19 72
Plugging commenced January 18 19 72
Plugging completed January 21 19 72
Reason for abandonment of well or producing formation Depleted

If a producing well is abandoned, date of last production 1-13 19 72
Was permission obtained from the Conservation Division or its agents before plugging was commenced? Yes

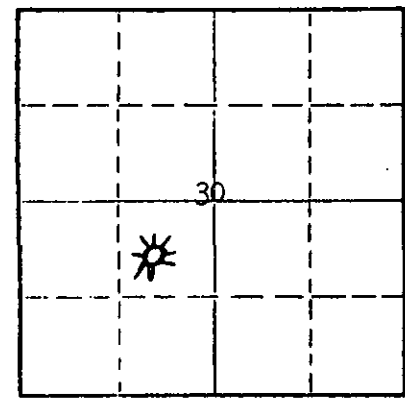

Locate well correctly on above Section Plat

Name of Conservation Agent who supervised plugging of this well Russel Biberstine
Producing formation Mississippi Chat Depth to top 4893 Bottom 4900 Total Depth of Well 4930 Feet
Show depth and thickness of all water, oil and gas formations.

OIL, GAS OR WATER RECORDS

CASING RECORD

FORMATION	CONTENT	FROM	TO	SIZE	PUT IN	PULLED OUT
Mississippi Chat	Gas	4893	4900	8-5/8" 4 1/2"	259.33 4929.5	4013.40

Describe in detail the manner in which the well was plugged, indicating where the mud fluid was placed and the method or methods used in introducing it into the hole. If cement or other plugs were used, state the character of same and depth placed, from _____ feet to _____ feet for each plug set.

Hole filled with sand being dumped filling hole from 4930' up to 4825'. Dumped 3 sacks cement with bailer. Bridged hole at 250' to 260'. Dumped 4 cu. yards Ready Mixed cement filling hole to surface.

(If additional description is necessary, use BACK of this sheet)

Name of Plugging Contractor Clarke Well Service
Address Medicine Lodge Kansas

STATE OF OKLAHOMA, COUNTY OF OKLAHOMA, ss.
S. D. Farrar (employee of owner) or (owner or operator) of the above-described

well, being first duly sworn on oath, says: That I have knowledge of the facts, statements, and matters herein contained and the log of the above-described well as filed and that the same are true and correct. So help me God.

(Signature) *S. D. Farrar*

P. O. Box 1841, Oklahoma City, Oklahoma 73116 (Address)

SUBSCRIBED AND SWORN TO before me this 2nd day of February, 19 72

My commission expires November 20, 1973 *Lois W. King* Notary Public.

DRILLERS LOG

#1 Davis Ranch "C"

CASING RECORD: 259.33' (12 Jts.)
 8-5/8" used surface casing
 TOTAL DEPTH: 4930'
 COMPANY: Schermerhorn Oil Corp. & Kenwood Oil Company
 CONTRACTOR: Strata Drilling, Inc.
 COMMENCED: September 21, 1959
 COMPLETED: October 8, 1959
 DESCRIPTION: NE SW Section 30-34S-14W Barber County, Kansas
 ELEVATION: 1682' GR

<u>FORMATION:</u>	<u>FROM</u>	<u>TO</u>	<u>REMARKS</u>	
Surface Clay & Sand	0	50	Ran 259.33' (12 Jts.) of used 8-5/8" surface casing: cement with 175 sacks of common cement, 2% C. C. @ 256'.	
Red Bed & Shells	50	825		
Shale	825	1710		
Shale, Lime Streaks	1710	2030		
Lime & Shale	2030	3620		
Shale	3620	3750		
Shale & Lime Streaks	3750	3850		
Lime, Shale & Sand	3850	3975		
Shale & Lime	3975	4192		
Lime	4192	4405		
Lime & Shale	4405	4502	DST #1 4872'-4905' tool open 1 hour, gas to surface in 23 minutes, not enough gauge. Recovered 15' gas cut mud. IBHP 1870 lbs. FBHP 1820 lbs. in 20 minutes.	
Lime	4502	4724		
Lime & Shale	4724	4780		
Lime	4780	4855		
Lime & Chert	4855	4905		
Lime	4905	4930		
Total Depth 4930'				DST #2 4906'-4930' tool open 1 hour, Recovered 5' mud. Strong blow throughout test. IBHP 240 lbs. FBHP 665 lbs. in 20 minutes.
				Ran (147 Jts.) of new 4 1/2" pipe set and cemented at 4929.5 with 60 sacks of posmix, plus 1/2 lb. flo seal per sack. Plug down @ 9:00 A. M. 10-8-1959.

RECEIVED
 STATE CORPORATION COMMISSION
 1-10-72
 JAN 10 1972
 CONSERVATION DIVISION
 Wichita, Kansas

STATE OF KANSAS)
) ss:
 COUNTY OF BARTON)

I certify that this is a true and correct copy of the above log to the best of my knowledge.

STRATA DRILLING, INC.

Jim B. McWilliams
 Jim B. McWilliams, Secy-Treas.

Subscribed and sworn to before me this 12th day of October, 1959.

Elaine H. Taylor
 Elaine H. Taylor - Notary Public

My Commission Expires
 December 14, 1961