


STATE OF KANSAS
STATE CORPORATION COMMISSION
CONSERVATION DIVISION
P. O. BOX 17027
WICHITA, KANSAS 67217

FORM CP-4

WELL PLUGGING RECORD

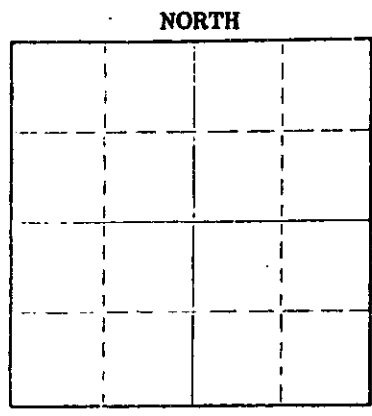

Locate well correctly on above Section Plot

Barber County, Sec. 33 Twp. 34 Rge. 14 (E) (W)
Location as "NE/CNW&SW" or footage from lines 1650' FWL 2310' FSL NWNE SW/4
Lease Owner: Cities Service Oil Company
Lease Name: EWB Ranch "A" Well No. 1
Office Address: 209 E. William, 700 Sutton Place, Wichita, KS 67202
Character of Well (completed as Oil, Gas or Dry Hole) Dry Hole
Date well completed 4-19-76 19
Application for plugging filed 4-19-76 19
Application for plugging approved 4-19-76 19
Plugging commenced 4-19-76 19
Plugging completed 4-19-76 19
Reason for abandonment of well or producing formation Dry Hole
If a producing well is abandoned, date of last production 19
Was permission obtained from the Conservation Division or its agents before plugging was commenced? Yes

Name of Conservation Agent who supervised plugging of this well G. Russell Biberstein
Producing formation _____ Depth to top _____ Bottom _____ Total Depth of Well _____ feet
Show depth and thickness of all water, oil and gas formations.

OIL, GAS OR WATER RECORDS

CASING RECORD

FORMATION	CONTENT	DEPTH FROM	TO	SIZE	PUT IN	PULLED OUT
	STATE OF KANSAS	WICHITA COUNTY	SIGN	8 5/8"	428'	Abandon in Hole
	PLUG	474073				
	PLUG	174073				
		5-17-76				
	CONSERVATION DIVISION WICHITA, KANSAS					

Describe in detail the manner in which the well was plugged, indicating where the mud fluid was placed and the method or methods used in introducing it into the hole. If cement or other plugs were used, state the character of same and depth placed, from _____ feet to _____ feet for each plug set.

35 Sack Plug at 375'
15 Sack Plug at 40' To Surface
2 Sack Plug in Rat Hole

(If additional description is necessary, use BACK of this sheet)

Name of Plugging Contractor Gabbert & Jones
Address 209 E. William, 830 Sutton Place, Wichita, Kansas 67202

STATE OF Kansas COUNTY OF Sedgwick
W. J. Devaney (employee of owner) or ~~XXXXXXXXXXXX~~ of the above-described

well, being first duly sworn on oath, says: That I have knowledge of the facts, statements, and matters herein contained and the log of the above-described well as filed and that the same are true and correct. So help me God.

Glenn E. Meier
STATE NOTARY PUBLIC
Sedgwick County, Kansas

(Signature) W. J. Devaney
Cities Service Oil Co.
(Address)

Subscribed and sworn to before me this 12th day of May 1976
My commission expires 6/3/77
Glenn E. Meier Notary Public

GABBERT-JONES, INC.
WICHITA, KANSAS
DRILLERS' WELL LOG

E. W. R. Ranch #1
NW-NE-SW Sec 33-34S-14W
Barber County Kansas

Commenced: 4-6-76

Completed: 4-19-76

RECEIVED
STATE OF KANSAS COMMISSIONER

MAY 17 1976
S-17-76
CONSERVATION DIVISION
Wichita, Kansas

OPERATOR: CITIES SERVICE OIL COMPANY

From	Depth to	Formation	Remarks
0	1152	Redbed	Ran 10 jts of 24# 2 5/8"
1152	1500	Shale	cas set @ 426' Cemented
1500	1840	Shale-Shells	w/300 sbs 50/50 Posmix
1840	4350	Lime-Shale	2% Gel - 3% CC
4350	4450	Lime	PD @ 11:00 a.m. 4-7-76
4450	4545	Lime-Shale	
4545	4715	Lime	
4715	4845	Lime-w/chert	
4845	4972	Lime	
	4972 TD		DRY & ABANDONED

I, James S. Sutton II, certify this is a correct copy for the Drillers' Log for the well drilled NW-NE-SW, Sec 33-34S-14W, Barber County Kansas to the best of my knowledge and belief.

James S. Sutton II
JAMES S. SUTTON II

STATE OF KANSAS)
) SS
COUNTY OF SEDGWICK)

Before me, the undersigned, a Notary Public within and for said County and State, on this 27th day of April, 1976, personally appeared James S. Sutton II to me personally known to be the identical person who executed the within and foregoing instrument and acknowledged to me that he executed the same as his free and voluntary act and deed for the uses and purposes therein set forth.

IN WITNESS WHEREOF, I have hereunto set my hand and official seal the day and year last above written.

Elizabeth J. Edwards
ELIZABETH J. EDWARDS-NOTARY PUBLIC

My Commission Expires: February 6, 1979.