


STATE OF KANSAS
STATE CORPORATION COMMISSION

WELL PLUGGING RECORD

Give All Information Completely
Make Required Affidavit
Mail or Deliver Report to
Conservation Division
State Corporation Comm.
245 North Water
Wichita, KS 67202

Barber County, Sec. 33 Twp. 30S Rge. 14W
Location as "NE/CNW $\frac{1}{2}$ SW $\frac{1}{2}$ " or footage from lines
C SW SE
Lease Owner Hummon Corporation
Lease Name Tempel Well No. 1
Office Address 400 One Main Place, Wichita, KS 67202
Character of Well (Completed as Oil, Gas or Dry Hole) _____

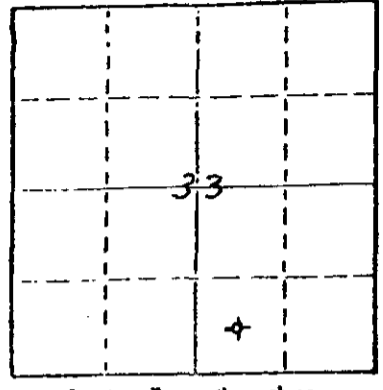

Locate well correctly on above
Section Plot

Dry Hole
Date Well completed October 8, 1980
Application for plugging filed October 8, 1980
Application for plugging approved October 8, 1980
Plugging commenced October 8, 1980
Plugging completed October 8, 1980
Reason for abandonment of well or producing formation _____

Dry Hole
If a producing well is abandoned, date of last production _____
19 _____

Was permission obtained from the Conservation Division or
its agents before plugging was commenced? Yes

Name of Conservation Agent who supervised plugging of this well Wm. T. Owen
Producing formation _____ Depth to top _____ Bottom _____ Total Depth of Well 4730'
Show depth and thickness of all water, oil and gas formations.

OIL, GAS OR WATER RECORDS

CASING RECORD

FORMATION	CONTENT	FROM	TO	SIZE	PUT IN	PULLED OUT
		0'	366'	8-5/8"	359.80'	None

Describe in detail the manner in which the well was plugged, indicating where the mud fluid was placed and the method or methods used in introducing it into the hold. If cement or other plugs were used, state the character of same and depth placed, from _____ feet to _____ feet for each plug set.

Plugged with 40 sacks cement at 360';
10 sacks cement and plug at 40';
and 10 sacks cement in rat hole.

RECEIVED
STATE CORPORATION COMMISSION
10-21-80
OCT 24 1980

(If additional description is necessary, use BACK of this sheet)


Name of Plugging Contractor Allied Cementing Co. CONSERVATION DIVISION
Wichita, Kansas

STATE OF KANSAS COUNTY OF SEDGWICK, ss.
John D. Knightley Agent (employee of owner) or (owner or operator)
of the above-described well, being first duly sworn on oath, says: That I have knowledge of the facts, statements, and matters herein contained and the log of the above-described well as filed and that the same are true and correct. So help me God.

(Signature) [Signature]
221 S. Broadway, Wichita, Kansas 67202
(Address)

SUBSCRIBED AND SWORN TO before me this 20th day of October, 1980

[Signature]
Notary Public.

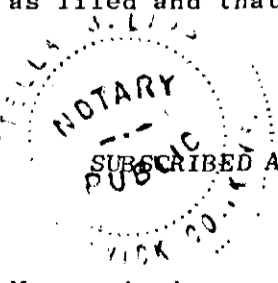

My commission expires March 12, 1983

Hummon Corporation - Tempel #1
 400 One Main Place C SW SE Sec. 33-30S-14W
 Wichita, Kansas 67202 Barber County, Kansas

Contractor: D. R. Lauck Oil Company, Inc.
 221 S. Broadway, Suite 400
 Wichita, Kansas 67202

Commenced: September 27, 1980
 Completed: October 8, 1980

Drillers Log

Red Bed	1265
Shale & Shells	1945
Shale	2110
Shale & Shells	2760
Shale & Lime	2883
Shale & Shells	3065
Shale & Lime	3515
Shale & Shells	3755
Lime	4240
Lime & Shale	4362
Lime	4485
Lime & Sand	4578
Lime	4730 RTD

RECEIVED
 STATE CORPORATION COMMISSION
 OCT 21 1980
 10-21-80
 CONSERVATION DIVISION
 Wichita, Kansas