

WELL PLUGGING RECORD

Give All Information Completely
Make Required Affidavit
Mail or Deliver Report to:
Conservation Division
State Corporation Commission
211 No. Broadway
Wichita, Kansas

Barber County, Sec. 5 Twp. 34 Rge. 12 (E) W (W)

Location as "NE/CNW/SE/SW" or footage from lines C N7/2 SE/4

Lease Owner K & E Drilling, Inc.

Lease Name Warwick Well No. 1

Office Address Wichita, Kansas

Character of Well (completed as Oil, Gas or Dry Hole)

Date well completed 19

Application for plugging filed 19

Application for plugging approved 19


Plugging commenced 6-8-65 19

Plugging completed 6-10-65 19

Reason for abandonment of well or producing formation Depleted.

If a producing well is abandoned, date of last production 19

Was permission obtained from the Conservation Division or its agents before plugging was commenced? yes

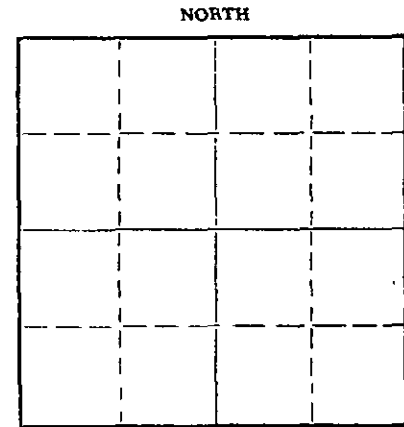

Locate well correctly on above Section Flat

Name of Conservation Agent who supervised plugging of this well Archie Elving

Producing formation Depth to top Bottom Total Depth of Well 4820 Feet

Show depth and thickness of all water, oil and gas formations.

OIL, GAS OR WATER RECORDS

CASING RECORD

FORMATION	CONTENT	FROM	TO	SIZE	PUT IN	PULLED OUT
				8-5/8"	270'	None
				4-1/2"	4805'	3536'

Describe in detail the manner in which the well was plugged, indicating where the mud fluid was placed and the method or methods used in introducing it into the hole. If cement or other plugs were used, state the character of same and depth placed, from feet to feet for each plug set.

Checked hole to 4820', sanded hole to 4800' and dumped 4 sacks of cement @ 4800' with dump bailer. Pulled 4 1/2" casing, bailed fluid from 100' to 260', set rock bridge to 250' and dumped 25 sacks of cement @ 250'. Mudded hole to 40', set rock bridge to 30' and ran 10 sacks of cement to base of cellar.

RECEIVED
STATE CORPORATION COMMISSION

JUN 18 1965

6-18-65

CONSERVATION DIVISION
Wichita, Kansas

PLUGGING COMPLETE.

(If additional description is necessary, use BACK of this sheet)

Name of Plugging Contractor KNIGHT CASING PULLING COMPANY

Address CHASE, KANSAS

STATE OF KANSAS, COUNTY OF RICE, ss.

Noel J. Knight (employee of owner) or (owner or operator) of the above-described well, being first duly sworn on oath, says: That I have knowledge of the facts, statements, and matters herein contained and the log of the above-described well as filed and that the same are true and correct. So help me God.

(Signature) Noel J. Knight

Chase, Kansas

(Address)

SUBSCRIBED AND SWORN TO before me this 15th day of June, 1965

Milton J. Tolin

Notary Public.

My commission expires May 20, 1968

15-007-3045-0000

DRILLER'S WELL LOG

OPERATOR: K & E DRILLING, INC.
719 Union Center
Wichita, Kansas

WELL NAME: T. H. Warwick "A" #1
LOCATION: C N/2 SE/4, 5-34S-12W
Barber County, Kansas

CONTRACTOR: K & E DRILLING, INC.
719 UNION CENTER BLDG.
WICHITA, KANSAS

COMMENCED: 2-23-65

CASING RECORD: 8-5/8" @ 270' w/175 sx.
4-1/2" @ 4805' w/100 sx.

COMPLETED: 3-8-65

ELEVATION: 1504' Grd.; 1510' DF
1513' KB

ROTARY TOTAL DEPTH: 4820

PRODUCTION: Gas

FORMATION RECORD

Depths shown indicate bottom of formations encountered.

Clay & Shale	65
Sand	105
Shale & Shells	175
Shale	830
Red Bed - Shale	1420
Shells & Shale	1955
Lime & Shale	2105
Lime	3475
Shale & Lime	3835
Lime	4788
Lime & Chert	4810
Lime	4820

RECEIVED
STATE CORPORATION COMMISSION

JUN 8 1965
6-8-65
CONSERVATION DIVISION
Wichita, Kansas

CERTIFICATION

State of KANSAS }
County of SEDGWICK } ss:

I, H. L. Wilson, of K&E DRILLING, INC., upon oath state
that the above and foregoing is a true and correct copy of the Driller's Log of the above named well.

Subscribed and sworn to before me this 16th day of March, 19 65

My Commission expires: 8-30-65

H. L. Wilson
H. L. Wilson
Julene M. Bannon
Julene M. Bannon Notary Public.

