


NORTH

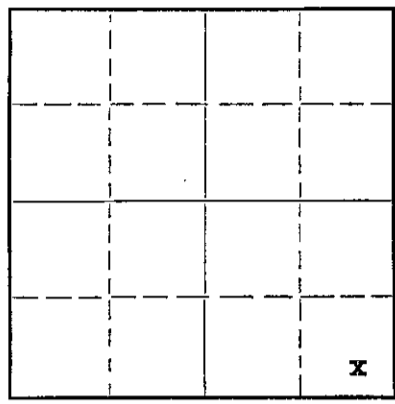

Locate well correctly on above Section Plat

Barton County, Sec 16 Twp 18S Rge 14 (E) W (W)
 Location as "NE/CNW $\frac{1}{4}$ SW $\frac{1}{4}$ " or footage from lines C SE SE SE/4
 Lease Owner Kantor Oil Company
 Lease Name Brown Well No. 1
 Office Address Box 846, Tulsa, Oklahoma
 Character of Well (completed as Oil, Gas or Dry Hole) dry hole
 Date well completed November 1 19 54
 Application for plugging filed October 31 19 54
 Application for plugging approved October 31 19 54
 Plugging commenced October 31 19 54
 Plugging completed November 1 19 54
 Reason for abandonment of well or producing formation dry hole

If a producing well is abandoned, date of last production _____ 19____
 Was permission obtained from the Conservation Division or its agents before plugging was commenced? Yes

Name of Conservation Agent who supervised plugging of this well Warren Horner
 Producing formation _____ Depth to top _____ Bottom _____ Total Depth of Well 3478 Feet
 Show depth and thickness of all water, oil and gas formations.

OIL, GAS OR WATER RECORDS

CASING RECORD

Formation	Content	From	To	Size	Put In	Pulled Out
surface casing		-0-	892	8 5/8"	892	None

Describe in detail the manner in which the well was plugged, indicating where the mud fluid was placed and the method or methods used in introducing it into the hole. If cement or other plugs were used, state the character of same and depth placed, from _____ feet to _____ feet for each plug set.

Filled with heavy mud to 300'
 Set plug at 300'.
 Cemented with 20 sacks cement through drill pipe.
 Filled with heavy mud to 35'.
 Set plug at 35'.
 Filled with 10 sacks cement to the bottom of the cellar.


(If additional description is necessary, use BACK of this sheet)
 Name of Plugging Contractor A. L. Jackson Drilling Company
 Address Box 194 Great Bend, Kansas

STATE OF Kansas, COUNTY OF Barton,
A. L. Jackson, drilling contractor on _____ the above-described well,
 being first duly sworn on oath, says: That I have knowledge of the facts, statements, and matters herein contained and the log of the above-described well as filed and that the same are true and correct. So help me God.

(Signature) A. L. Jackson
Box 194 Great Bend, Kansas
 (Address)

SUBSCRIBED AND SWORN TO before me this 1st day of November, 19 54.

My commission expires May 9, 1955 _____ Notary Public.

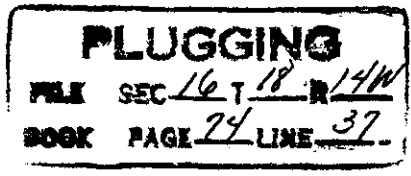

WELL LOG
Brown #1
Barton County, Kansas

0 - 40	Surface Clay
40 - 100	Sand and Shale
100 - 150	Shale
150 - 305	Shale and Shells
305 - 420	Sand
420 - 495	Shale and Shells
495 - 535	Blue Shale
535 - 700	Red Bed
700 - 877	Red Bed and Shells
877 - 912	Anhydrite
912 - 1030	Shale and Shells
1030 - 1150	Red Bed and Shells
1150 - 1400	Salt
1400 - 1640	Shale and Shells
1640 - 2115	Lime and Shale
2115 - 2150	Shale and Lime
2150 - 2660	Shale and Shells
2660 - 2805	Lime and Shale
2805 - 2890	Shale and Lime
2890 - 3050	Lime and Shale
3050 - 3062	Lime
3062 - 3068	Shale
3068 - 3085	Lime and Shale
3085 - 3115	Lime
3115 - 3119	Heebner
3119 - 3139	Lime
3139 - 3190	Lime and Shale
3190 - 3200	Brown Lime
3200 - 3225	Lancing Lime
3225 - 3330	Lime
3330 - 3395	Lime EC
3395 - 3446	Lime and Shale
3446 - 3452	Arbuckle
3452 - 3478	Arbuckle Lime
3478	T. D.

STATE OF KANSAS
COUNTY OF BARTON ss

A. L. Jackson, owner of A. L. Jackson Drilling Co., being first duly sworn on oath, says: That I have knowledge of the facts, statements, and matters herein contained and the log of the above described well as filed and that the same are true and correct.

A. L. Jackson
A. L. Jackson
Box 194
Great Bend, Kansas

Subscribed and sworn to before me this 1st day of November, 1954.

My commission expires May 9, 1955.

