

KANSAS

STATE CORPORATION COMMISSION

CONSERVATION DIVISION AGENT'S REPORT

Form CP-3

Rev. 6-4-68

RECEIVED  
STATE CORPORATION COMMISSION

DEC 26 1978  
12-26-78  
CONSERVATION DIVISION  
Wichita, Kansas

J. Lewis Brock  
Administrator  
245 North Water  
Wichita, KS 67202

API Number 15-007-10267-0001 (of this well)

Operator's Full Name Texas Oil & Gas Corp.

Complete Address 200 W. Douglas Suite 300 Wichita, KS.

Lease Name Truck "D" Well No. 1

Location C-E/2-NW-NE Sec. 17 Twp. 32 Rge. 15 (E) (W) X

County Barber Total Depth 4835

Abandoned Oil Well      Gas Well X Input Well      SWD Well      D & A     

Other well as hereafter indicated     

Plugging Contractor Clarks Corp.

Address 107 W. Fowler Medicine Lodge, KS 67104 License No. 583

Operation Completed: Hour 1 pm Day 22 Month 12 Year 1978

The above well was plugged as follows:

DNW, C-1017'-8 5/8" casing - 4 1/2" casing set @ 4801 w/ 125 sq Cement  
34' open hole. Sand back to 4790' topped sand w/ 4 sack mixed  
Cement w/ dump hauled pull 4060' 4 1/2" casing - (filled  
mixed & pumped 100 sq 50/50 primary Cement w/ 39 cc  
to top of casing - run 2 wipers plugs ahead of cement -

I hereby certify that the above well was plugged as herein stated.

INVOICED

Signed: [Signature]  
Well Plugging Supervisor


DATE 12-28-78  
INV. NO. 8810-W

15-007-20567-00-01

WELL : Rusk "1" #1

LOCATION : 660' FNL & 1650' FEL SEC 17-32S-15W, BARBER Co., KS

ELEVATION : 1941 G.L. 1949 K.B.

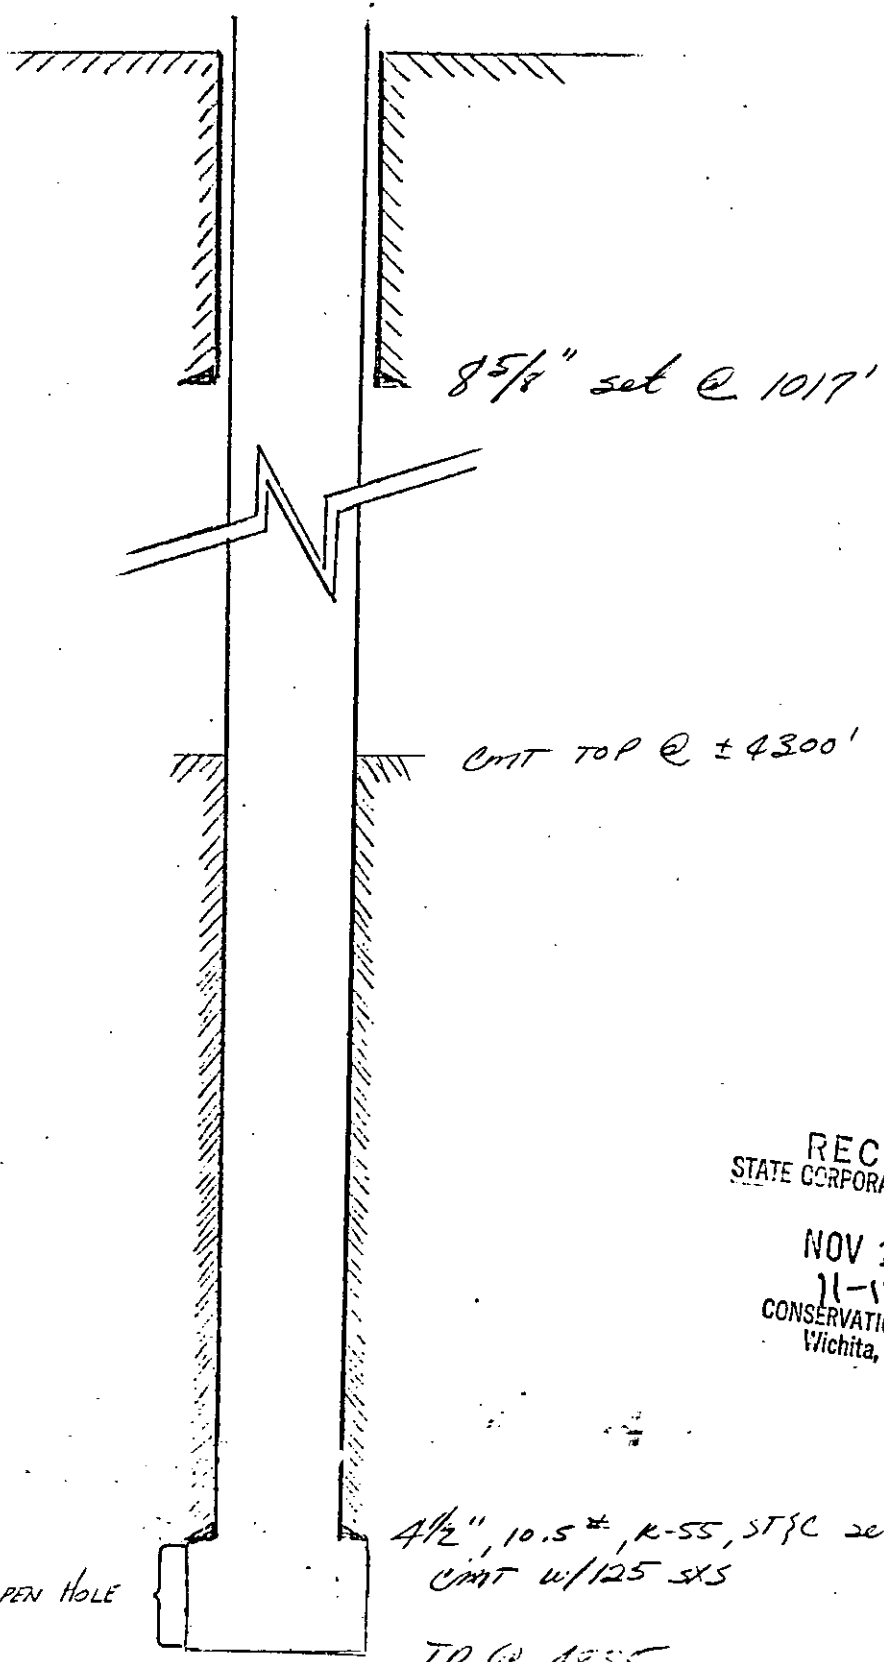

8 5/8" set @ 1017'

CMT TOP @ ± 4300'

34' OPEN HOLE

4 1/2" 10.5 #, K-55, STFC set @ 4801' K.B.  
CMT w/125 SX5

TD @ 4855

RECEIVED  
STATE CORPORATION COMMISSION

NOV 13 1978  
11-13-78  
CONSERVATION DIVISION  
Wichita, Kansas