


STATE OF KANSAS
STATE CORPORATION COMMISSION

WELL PLUGGING RECORD

Give All Information Completely
Make Required Affidavit
Mail or Deliver Report to
Conservation Division
State Corporation Comm.
245 North Water
Wichita, KS 67202

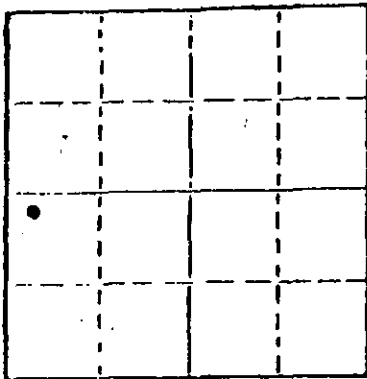

Locate well correctly on above
Section Plot

County. Sec. 20 Twp. 31S Rge. 16 E/W
Location as "NE/CNW $\frac{1}{4}$ SW $\frac{1}{4}$ " or footage from lines
2400' ESL and 400' FWL (App NW NW SW)
Lease Owner Mesa Petroleum
Lease Name KAY Petroleum Well No. 1-20
Office Address Box 1578, Liberal, KS 67901
Character of Well (Completed as Oil, Gas or Dry Hole) DRY HOLE

Date Well completed 3/27 19 80
Application for plugging filed 19
Application for plugging approved (verbal) 3/26 19 80
Plugging commenced 3/26 19 80
Plugging completed 3/27 19 80
Reason for abandonment of well or producing formation DRY HOLE

If a producing well is abandoned, date of last production 19

Was permission obtained from the Conservation Division or
its agents before plugging was commenced? Yes

Name of Conservation Agent who supervised plugging of this well Wm. T. Owen
Producing formation - Depth to top - Bottom - Total Depth of Well 5589'
Show depth and thickness of all water, oil and gas formations.

OIL, GAS OR WATER RECORDS

CASING RECORD

FORMATION	CONTENT	FROM	TO	SIZE	PUT IN	PULLED OUT
				8-5/8"	485'	NONE

Describe in detail the manner in which the well was plugged, indicating where the mud fluid was placed and the method or methods used in introducing it into the hold. If cement or other plugs were used, state the character of same and depth placed, from feet to feet for each plug set.

Plugged well as follows: 50 sacks at 480' - 10 sacks at 40' - 5 sacks in
rathole. Job complete at 4:30AM 3/27/80. Cut off pipe and welded on ID cap.

RECEIVED
MAR 28 1980
CONSERVATION DIVISION
WICHITA, KANSAS

(If additional description is necessary, use BACK of this sheet)

Name of Plugging Contractor B.J. Hughes, Woodward, Oklahoma 73801

STATE OF Kansas COUNTY OF Seward, ss.
Ned E. Lowry (employee of owner) or (owner or operator)
of the above-described well, being first duly sworn on oath, says: That I have knowledge of
the facts, statements, and matters herein contained and the log of the above-described well
as filed and that the same are true and correct. So help me God.


(Signature) Ned E. Lowry

P.O. Box 1578, Liberal, KS 67901

(Address)

SUBSCRIBED AND SWORN TO before me this 27th day of March, 19 80

My commission expires 4-13-82

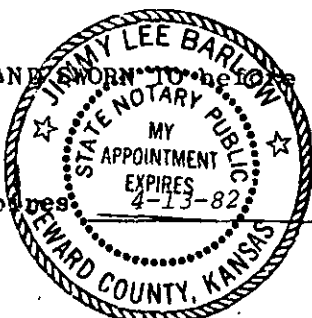

Jimmy Lee Barlow Notary Public.

State of Kansas



JOHN CARLIN
R. C. LOUX
JANE T. ROY
WILLIAM G. GRAY

Governor
Chairman
Commissioner
Commissioner

Carol J. Larson, Executive Secretary

State Corporation Commission

CONSERVATION DIVISION

(Oil, Gas and Water)
245 North Water
WICHITA, KANSAS 67202

March 31, 1980

WELL PLUGGING AUTHORITY

Kay Well No. 1-20
NW NW SW, Sec. 20-31S-16W
Comanche County
5589'
Search Drilg. Co.


Mesa Petroleum Company
50 Penn Place, Suite 1200
Oklahoma City, OK 73118

Gentlemen:

This is your authority to plug the above subject well in accordance with the Rules and Regulations of the State Corporation Commission.

This authority is void after ninety (90) day from the above date.

Yours very truly,

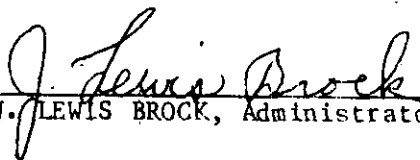
J. LEWIS BROCK, Administrator

Mr. William T. Owen, Box 369, Pratt, KS 67124

is hereby assigned to supervise the plugging of the above named well