


STATE OF KANSAS  
STATE CORPORATION COMMISSION

Give All Information Completely  
Make Required Affidavit  
Mail or Deliver Report to:  
Conservation Division  
State Corporation Commission  
211 No. Broadway  
Wichita, Kansas

WELL PLUGGING RECORD

NORTH

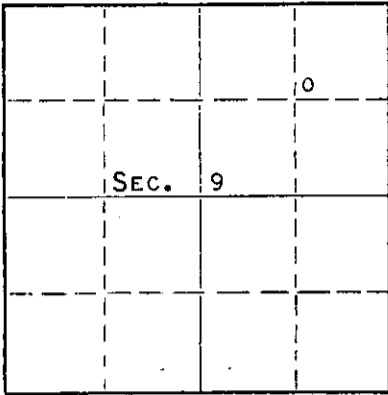

Locate well correctly on above  
Section Plat

COMANCHE County. Sec. 9 Twp. 31S Rge. 16W (X) (W)  
Location as "NE/CNW&SW&" or footage from lines APPROX. C-NE  
Lease Owner PETROLEUM, INC.  
Lease Name HASHKNIFE UNIT Well No. 1  
Office Address ROUTE 2, GREAT BEND, KANSAS  
Character of Well (completed as Oil, Gas or Dry Hole) DRY HOLE  
Date well completed DECEMBER 27 1961  
Application for plugging filed JANUARY 3 1961  
Application for plugging approved JANUARY 5 1962  
Plugging commenced JANUARY 6 1962  
Plugging completed JANUARY 13 1962  
Reason for abandonment of well or producing formation NO PRODUCIBLE FORMATIONS

If a producing well is abandoned, date of last production NONE 19  
Was permission obtained from the Conservation Division or its agents before plugging was commenced? YES

Name of Conservation Agent who supervised plugging of this well W. L. LACKAMP, JR.  
Producing formation \_\_\_\_\_ Depth to top \_\_\_\_\_ Bottom \_\_\_\_\_ Total Depth of Well 4944 Feet  
Show depth and thickness of all water, oil and gas formations.

OIL, GAS OR WATER RECORDS

CASING RECORD

FORMATION	CONTENT	FROM	TO	SIZE	PUT IN	PULLED OUT
MISSISSIPPI	WATER AND SMALL AMOUNT OF GAS.	4866	4874	8-5/8"	909'	NONE
				4-1/2"	4941	4274'

Describe in detail the manner in which the well was plugged, indicating where the mud fluid was placed and the method or methods used in introducing it into the hole. If cement or other plugs were used, state the character of same and depth placed, from \_\_\_\_\_ feet to \_\_\_\_\_ feet for each plug set.

PLUGGED BACK T.D. 4885'. PLUGGED OFF BOTTOM OF HOLE FROM 4885' TO 4800' WITH CRUSHED ROCK AND FOUR SACKS CEMENT. MUDDED UP WITH HEAVY MUD TO 300' AND BUILT SOLID ROCK BRIDGE PLACED 20 SACKS CEMENT ON ROCK BRIDGE. MUDDED UP WITH HEAVY MUD TO 40' AND BUILT SOLID ROCK BRIDGE. PLACED 10 SACKS CEMENT, ON TO ROCK BRIDGE TO BASE OF WELL CELLAR.

RECEIVED  
STATE CORPORATION COMMISSION  
JAN 18 1962  
CONSERVATION DIVISION  
Wichita, Kansas

(If additional description is necessary, use BACK of this sheet)  
Name of Plugging Contractor MORGAN WELL PLUGGING SERVICE  
Address 102 WEST 18TH ST., HUTCHINSON, KANSAS

STATE OF KANSAS, COUNTY OF BARTON, ss.  
DON SEARLE (employee of owner) or (owner or operator) of the above-described well, being first duly sworn on oath, says: That I have knowledge of the facts, statements, and matters herein contained and the log of the above-described well as filed and that the same are true and correct. So help me God.

(Signature) Don Searle  
ROUTE 2, GREAT BEND, KANSAS  
(Address)

SUBSCRIBED AND SWORN TO before me this 15TH day of JANUARY, 1962

Arthur J. Wile  
Notary Public.

My commission expires APRIL 14, 1963



# WELL LOG

COMPANY PETROLEUM, INCORPORATED

SEC. 9 T.31S R. 16W

FARM HASHKNIFE UNIT NO. 1

LOC. Approx. C-NE/4


TOTAL DEPTH 4944'

COUNTY COMANCHE CO., KANSAS

COMM. November 27, 1961 COMP. December 13, 1961

CONTRACTOR GARVEY DRILLING COMPANY

CASING 8-5/8" @ 909' w/550 sax.  
4 1/2" @ 4941' w/100 sax.

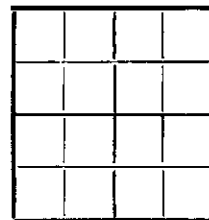

ELEVATION 1990' DF

PRODUCTION Dry and Abandoned

FIGURES INDICATE BOTTOM OF FORMATIONS

75	Surface soil & gyp rock
220	Shale & red bed
240	Anhydrite
810	Red bed
900	Red bed & shells
910	Anhydrite
1085	Red bed
2025	Shale & lime
2215	Lime & shale
2355	Lime
2860	Lime & shale
3650	Shale & lime
3740	Lime & shale
4944	Lime
4944	T. D.

RECEIVED  
STATE COMMISSION

JAN 13 1962

CONSERVATION DIVISION  
Wichita, Kansas

State of KANSAS

County of BARTON

I, VERNE A. MORRIS of GARVEY DRILLING COMPANY

upon oath state the above and foregoing is a true and correct copy of the log of the #7 HASHKNIFE UNIT well.

Subscribed and sworn to before me this 4th day of January 1962

My Commission Expires: April 14, 1963

*Arthur J. Miles*  
NOTARY PUBLIC