


15-007-00028-0000

STATE OF KANSAS
STATE CORPORATION COMMISSION

Give All Information Completely
Make Required Affidavit
Mail or Deliver Report to:
Conservation Division
State Corporation Commission
212 North Market, Insurance Bldg.
Wichita, Kansas

WELL PLUGGING RECORD

NORTH

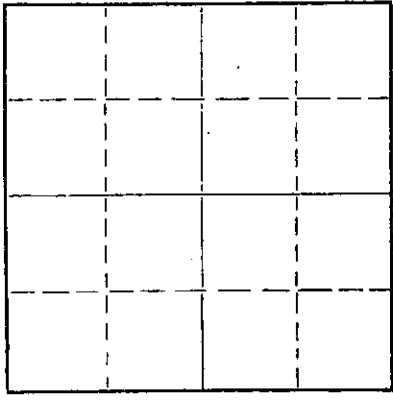

Locate well correctly on above
Section Flat

Barber County, Sec. 6 Twp. 32 Rge. 15 (E) W (W)
Location as "NE/CNW/SEW/4" or footage from lines C SE SW
Lease Owner Aylward Drilling Company
Lease Name Rusk Well No. 1
Office Address Wichita, Kansas
Character of Well (completed as Oil, Gas or Dry Hole)
Date well completed July 9 1961
Application for plugging filed September 25 1961
Application for plugging approved September 25 1961
Plugging commenced 9-28-61 19
Plugging completed 10-3-61 19
Reason for abandonment of well or producing formation Depleted.

If a producing well is abandoned, date of last production September 8 1961
Was permission obtained from the Conservation Division or its agents before plugging was commenced? yes

Name of Conservation Agent who supervised plugging of this well Fred Hample
Producing formation Mississippi Depth to top 4832 Bottom 4898 Total Depth of Well 4920 Feet
Show depth and thickness of all water, oil and gas formations.

OIL, GAS OR WATER RECORDS


CASING RECORD

FORMATION	CONTENT	FROM	TO	SIZE	PUT IN	PULLED OUT
				8-5/8"	187'	None
				4-1/2"	4870'	4313'

Describe in detail the manner in which the well was plugged, indicating where the mud fluid was placed and the method or methods used in introducing it into the hole. If cement or other plugs were used, state the character of same and depth placed, from _____ feet to _____ feet for each plug set.

Checked hole to 4920', squeezed off bottom @ 4872' with 31 sacks of cement. Pulled 4 1/2" casing. Checked fluid to 90', bailed fluid to 185', set 10' rock bridge to 175' and ran 20 sacks of cement. Mudded to 35' set 5' rock bridge to 30' and ran 10 sacks of cement to top.

PLUGGING COMPLETE.

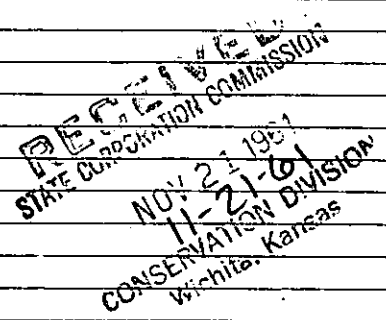

(If additional description is necessary, use BACK of this sheet)
Name of Plugging Contractor Knight Casing Pulling Company
Address Chase, Kansas

STATE OF Kansas COUNTY of Rice, ss.
Noel J. Knight (employee of owner) or (owner or operator) of the above-described well, being first duly sworn on oath, says: That I have knowledge of the facts, statements, and matters herein contained and the log of the above-described well as filed and that the same are true and correct. So help me God.

(Signature) Noel J. Knight
Chase, Kansas
(Address)

SUBSCRIBED AND SWORN TO before me this 4th day of October, 1961

Melton J. Volin
Notary Public.

My commission expires May 20, 1964

15-007-00028-0000

RUSK NO. 1

Casing Record:

Company: Aylward Drilling Company
 Contractor: Aylward Drilling Company

Location: C SE SW
 Sec. 6-32S-15W
 Barber County
 Kansas

8 5/8" @ 187'
 4 1/2" @ 4872'

Commenced: June 11, 1961
 Completed: June 25, 1961

Elev. 1991 DF, 1994 KB

	<u>From</u>	<u>To</u>	<u>Remarks</u>
Shale	0	50	Set 8 5/8" surface pipe @ 187' w/165 sacks
Red Bed	50	1080	
Shale	1080	1232	Geological Tops: (Log)
Shale & Shells	1232	2000	
Lime & Shale	2000	2410	Elgin 3979
Lime	2410	3080	Heebner 4119
Lime & Shale	3080	3380	Douglas 4154
Lime	3380	3600	Douglas Sandstone 4189
Lime & Shale	3600	3680	Brown Lime 4276
Lime	3680	3765	Lansing 4298
Lime & Shale	3765	3907	Marmaton 4683
Shale & Lime	3907	3973	Mississippi Chert 4832
Lime & Shale	3973	4200	Mississippi Limestone 4898
Lime & Sandy Shale	4200	4303	
Lime	4303	4845	DST #1 - 4670-4782 Open 1 hr., good blow.
Mississippi	4845	4915	Rec. 960' gas in pipe, 45' very slighty gas
Lime	4915	4920 T.D.	cut mud, IBHP 235#/20" - FBHP 110#/30", IFP 80# - FFP 90#
			DST #2 4812-62 Open 1 hr., GTS 58 min., TSTM Rec. 90' very slightly gas cut mud IBHP 201#/20" - FBHP 78#/30", IFP 67# - FFP 78#
			DST #3 4812-4920 Open 1 hr. 40min., GTS 2 min., Gauge 801,000 CFG/5", 584,000/10", 584,000/20", 481,000/30", 396,000/40", 362,000/50", 340,000/60", 310,000/70", 280,000/80", 275,000/90", 275,000/10", Rec. 90' gas cut mud IBHP 1336#/20" - FBHP 513#/30" IFP 178# - FFP 156#
			Set 4 1/2" casing @ 4872' w/75 sacks

I hereby certify that this is a true and correct copy of the above log to the best of my knowledge.

Charles Williams

Subscribed and sworn to before me this 29th day of June, 1961

Dwane Jessup

 DWANE JESSUP Notary Public

My Commission expires December 11, 1961

RECEIVED
 STATE CORPORATION COMMISSION
 NOV 21 1961
 11-21-61
 CONSERVATION DIVISION
 Wichita, Kansas