

STATE OF KANSAS, STATE CORPORATION COMMISSION


WELL PLUGGING RECORD

Give All Information Completely Make Required Affidavit Mail or Deliver Report to: Conservation Division State Corporation Commission 212 North Market, Insurance Bldg. Wichita, Kansas

Barber

County, Sec. 3 Twp. 32 Rge. (E) 15 (W)

NORTH

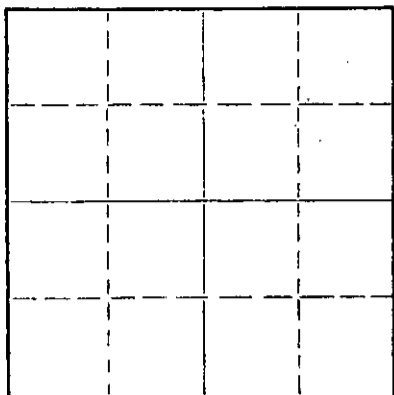

Locate well correctly on above Section Plat

Location as "NE/CNW/SW" or footage from lines SW SW SW
Lease Owner Aylward Drilling Company
Lease Name Skinner "D" Well No. 9
Office Address 813 1st National Bank Bldg. - Wichita 2, Kansas
Character of Well (completed as Oil, Gas or Dry Hole) Dry Hole
Date well completed October 4 1960
Application for plugging filed October 4 1960
Application for plugging approved October 4 1960
Plugging commenced October 4 1960
Plugging completed October 4 1960
Reason for abandonment of well or producing formation

If a producing well is abandoned, date of last production 19
Was permission obtained from the Conservation Division or its agents before plugging was commenced? Yes

Name of Conservation Agent who supervised plugging of this well Fred Hample
Producing formation Depth to top Bottom Total Depth of Well 4940 Feet
Show depth and thickness of all water, oil and gas formations.

OIL, GAS OR WATER RECORDS

CASING RECORD

Table with 7 columns: FORMATION, CONTENT, FROM, TO, SIZE, PUT IN, PULLED OUT. Row 1: SIZE 8 5/8", PUT IN 280, PULLED OUT None.

Describe in detail the manner in which the well was plugged, indicating where the mud fluid was placed and the method or methods used in introducing it into the hole. If cement or other plugs were used, state the character of same and depth placed, from feet to feet for each plug set.

Filled with mud to 270 feet
Set plug at 270 feet with 15 sacks cement
Filled with mud to 35 feet
Set plug at 35 feet with 10 sacks cement dry
Bridged rat hole and plugged with 2 sacks cement dry

RECEIVED
NOV 21 1960
CONSERVATION DIVISION
Wichita, Kansas

(If additional description is necessary, use BACK of this sheet)
Name of Plugging Contractor Aylward Drilling Company
Address 813 1st National Bank Bldg. - Wichita 2, Kansas

STATE OF KANSAS, COUNTY OF SEDGWICK, ss.
Charles D. Williams (owner or operator) of the above-described well, being first duly sworn on oath, says: That I have knowledge of the facts, statements, and matters herein contained and the log of the above-described well as filed and that the same are true and correct. So help me God.
(Signature) Charles D. Williams
813 1st Nat'l Bank Bldg., Wichita 2, Kansas (Address)

SUBSCRIBED AND SWORN to before me this 6th day of October, 1960

My commission expires December 11, 1961
DUANE JESSUP Notary Public.

SKINNER "D" NO. 9

Casing Record: Company: Aylward Drilling Company et al Location: SW SW SW
 8 5/8" - 280' Contractor: Aylward Drilling Company Sec. 3-32-15W
 Barber County
 Commenced: September 20, 1960
 Completed: October 4, 1960 Elevation: 2000 K.B.

	<u>From</u>	<u>To</u>	<u>Remarks</u>
Sandy Clay	0	70	Set 8 5/8" surface pipe @ 280' w/225 sacks cement
Red Bed	70	120	
Sand	120	130	
Red Bed & Shale	130	160	Geological Tops:
Red Bed	160	170	
Gyp	170	195	Heebner 4125
Red Bed, Shells & Shale	195	750	Douglas Sand 4183
Red Bed & Shale	750	1146	Lansing-Kan. City 4303
Shale & Shells	1146	1580	Base Kansas City 4747
Shale	1580	1700	Marmaton 4767
Shale & Lime	1700	2165	Mississippi 4830
Lime	2165	2540	
Lime & Shale	2540	2660	DST 4833-80 Open 30 min. Wk. bl./10"
Lime	2660	2725	Rec. 50' mud. IBHP 156#/20" -
Lime & Shale	2725	3000	FBHP 111#/15". FP 44#-67#.
Shale & Shells	3000	3100	
Shale & Lime	3100	3205	DST 4880-4910 Open 30 min.
Shale	3205	3240	Wk. bl./4". Rec. 30' mud
Shale & Shells	3240	3450	IBHP 337#/20" - FBHP 67#/15"
Shale	3450	3595	FP 44#-44#.
Shale & Lime	3595	3695	
Shale w/some Lime	3695	3820	DST 4910-40 Open 30 min. Wk. bl/3"
Shale & Lime	3820	3945	Rec. 15' mud. IBHP 491#/20" -
Lime & Shale	3945	4065	FBHP 67#/15". FP 22#-22#.
Shale	4065	4152	
Lime & Shale	4152	4295	
Lime	4295	4809	
Lime & Shale	4809	4873	D & A
Dolomite	4873	4940 T.D.	

RECEIVED
 STATE CORPORATION COMMISSION
 NOV 21 1960
 11-21-60
 CONSERVATION DIVISION
 Wichita, Kansas

I hereby certify that this is a true and correct copy of the above log to the best of my knowledge.

Charles D Williams

Subscribed and sworn to before me this 10th day of October, 1960

Duane Jessup
 DUANE JESSUP Notary Public

My commission expires December 11, 1961