

STATE OF KANSAS
STATE CORPORATION COMMISSION
CONSERVATION DIVISION
P. O. BOX 17027
TOPEKA, KANSAS 67217

FORM CP-4

WELL PLUGGING RECORD

Barber County, Sec 3 Twp 32 Rge 15 (E) W (W)

Location as "NE/CNW/SW" or footage from lines SW SW SE

Lease Owner Westmore Drilling Co., Inc.

Lease Name Skinner 'D' Well No. 4

Office Address Chapin Bldg., Medicine Lodge, Kansas

Character of Well (completed as Oil, Gas or Dry Hole)

Date well completed 19

Application for plugging filed August 1974

Application for plugging approved August 1974


Plugging commenced September 4 1974

Plugging completed September 20 1974

Reason for abandonment of well or producing formation

If a producing well is abandoned, date of last production 19

Was permission obtained from the Conservation Division or its agents before plugging was commenced? Yes

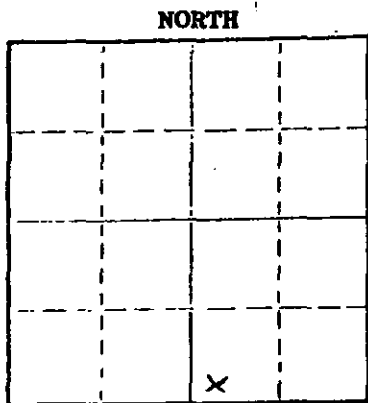

Locate well correctly on above Section Plat

Name of Conservation Agent who supervised plugging of this well Russell Biberstein

Producing formation Depth to top Bottom Total Depth of Well

Show depth and thickness of all water, oil and gas formations.

OIL, GAS OR WATER RECORDS

CASING RECORD

FORMATION	CONTENT	FROM	TO	SIZE	PUT IN	PULLED OUT
				8 5/8"	290	None
				5 1/2"	4884	3709

RECEIVED
STATE CORPORATION COMMISSION

NOV 22 1974

11-22-74
CONSERVATION DIVISION
Wichita, Kansas

Describe in detail the manner in which the well was plugged, including where the mud fluid was placed and the method or methods used in introducing it into the hole. If cement or other plugs were used, state the character of same and depth placed, from feet to feet for each plug set.

September 4, 1974 Plugged off bottom. Dumped sand to 4900'. Mixed and dumped 5 sx of cement.

September 20, 1974 Plugged off top. Set 10' rock bridge at 240'. Filled 8 5/8" surface casing from 240' to base of cellar with 3000 lb. P.S.I. ready-mix concrete.

(If additional description is necessary, use BACK of this sheet)

Name of Plugging Contractor RUSS CASING PULLING, INC.

Address P. O. Box 1082; Great Bend, Kansas 67530

STATE OF KANSAS COUNTY OF BARBER ss. R. O. Thompson (employee-of-owner) or (owner or operator) of the above-described

well, being first duly sworn on oath, says: That I have knowledge of the facts, statements, and matters herein contained and the log of the above-described well as filed and that the same are true and correct. So help me God.

WESTMORE DRILLING COMPANY, INC.

(Signature) [Signature]

Chapin Building, Medicine Lodge, Kansas

(Address)

SUBSCRIBED AND SWORN TO before me this 21st day of November, 1974

My commission expires 2-22-76

[Signature] Imogene Fitzsimmons Notary Public

SKINNER "D" NO. 4

Casing Record: Company: Aylward Drilling Company et al Location: SW SW SE 3-32-15W
 Contractor: Aylward Drilling Company Barber County
 Kansas
 8 5/8" - 290' Commenced: June 18, 1958 Elevation: 1996 RB
 5 1/2" - 4884' Completed: July 4, 1958

	From	To	Remarks
Sand	0	50	Set 8 5/8" surface pipe @ 290' w/250 sacks cement.
Red Rock	50	95	
Sand	95	125	
Red Rock & Gyp	125	300	Geological Tops:
Red Bed & Shells	300	930	Heebner Shale 4120
Anhydrite	930	1051	Base/Oread 4157
Shale & Shells	1051	1165	Douglas Sand 4201
Salt	1165	1210	Lansing 4302
Shale & Lime Shells	1210	1301	B/Kansas City 4740
Shale & Shells	1301	1970	Miss. 4831
Shale w/Lime Strks.	1970	2160	T.D. 4903
Mostly Lime w/some Shale	2160	2330	
Lime	2330	2830	DST 4861-4903 Open 35 min. Gas/2 1/2 min. 428 MCFG/5", 214 MCFG/10", fl. mud/10", Fl. Oil/12". Rec. 35 BO from flowing & in drill pipe. IBHP 1540#/20", FBHP 1530#/30"... FP 875#-1325#.
Lime w/Shale	2830	2920	
Lime & Shale	2920	3045	Set 5 1/2" @ 4884' w/75 sacks cement.
Shale & Lime	3045	3165	
Shale w/Lime	3165	3385	
Shale & Lime	3385	3470	
Lime & Shale	3470	3665	
Shale & Lime	3665	3720	
Lime & Shale	3720	3918	
Mostly Lime - some Shale	3918	3965	
Lime & Shale	3965	4048	
Lime w/Shale	4048	4103	
Lime & Shale	4103	4173	
Sandy Lime & Shale	4173	4280	
Lime	4280	4689	
Lime w/Shale	4689	4716	
Lime	4716	4809	
Lime w/Shale	4809	4848	
Lime, very little shale	4848	4903 T.D.	

RECEIVED
 STATE CORPORATION COMMISSION
 AUG 14 1974
 8-14-74
 CONSERVATION DIVISION
 Wichita, Kansas

I hereby certify that this is a true and correct copy of the above log to the best of my knowledge.

Paul W. Hesse

Subscribed and sworn to before me this 16th day of July, 1958.

Duane Jessup
 DUANE JESSUP Notary Public

My Commission expires December 11, 1961.