


STATE OF KANSAS
 STATE CORPORATION COMMISSION
 CONSERVATION DIVISION
 P. O. BOX 17027
 WICHITA, KANSAS 67217

WELL PLUGGING RECORD

Barber County, Sec. 3 Twp. 32 Rge. 15 (E) W (W)
 Location as "NE/CNW/SW" or footage from lines SE SE NE
 Lease Owner Westmore Drlg. Co., Inc.
 Lease Name Skinner 'D' Well No. 1
 Office Address Chapin Bldg., Medicine Lodge, Ks.
 Character of Well (completed as Oil, Gas or Dry Hole)
 Date well completed 1974
 Application for plugging filed August 1974
 Application for plugging approved August 1974
 Plugging commenced September 11 1974
 Plugging completed September 20 1974
 Reason for abandonment of well or producing formation

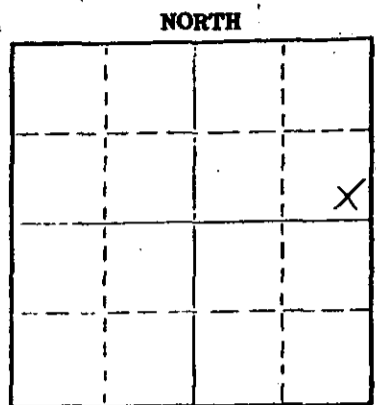

If a producing well is abandoned, date of last production 1974
 Was permission obtained from the Conservation Division or its agents before plugging was commenced? Yes

Name of Conservation Agent who supervised plugging of this well Russell Biberstein
 Producing formation Depth to top Bottom Total Depth of Well Feet
 Show depth and thickness of all water, oil and gas formations.

OIL, GAS OR WATER RECORDS				CASING RECORD		
FORMATION	CONTENT	FROM	TO	SIZE	PUT IN	PULLED OUT
				8 5/8"	200	None
				5 1/2"	4901	3284
RECEIVED STATE CORPORATION COMMISSION NOV 22 1974 11-22-74 CONSERVATION DIVISION Wichita, Kansas						

Describe in detail the manner in which the well was plugged, indicating where the mud fluid was placed and the method or methods used in introducing it into the hole. If cement or other plugs were used, state the character of same and depth placed, from feet to feet for each plug set.

September 11, 1974 Plugged off bottom. Dumped sand to 4200'. Mixed and dumped 5 sx of cement.
 September 20, 1974 Plugged off top. Set 10' rock bridge at 300'. Filled casing and hole from 300' to base of cellar with 3000 lb. P.S.I. ready-mix concrete.

(If additional description is necessary, use BACK of this sheet)
 Name of Plugging Contractor RUSS CASING PULLING, INC.
 Address P. O. Box 1082 ; Great Bend, Kansas 67530

STATE OF KANSAS COUNTY OF BARBER ss.
 R. O. Thompson (employee of owner) or (owner or operator) of the above-described well, being first duly sworn on oath, says: That I have knowledge of the facts, statements, and matters herein contained and the log of the above-described well as filed and that the same are true and correct. So help me God. WESTMORE DRILLING COMPANY, INC.
 (Signature) [Signature]
 Chapin Building, Medicine Lodge, Kansas (Address)

SUBSCRIBED AND SWORN TO before me this 21st day of November 1974

My commission expires 2-22-76 Imogene Fitzsimmons Notary Public

SKINNER "D" NO. 1

Casing Records:

Company: Aylward Drilling Company et al

Location: SE SE NE

8 5/8" - 100'
5 1/2" - 4901'

Contractor: Aylward Drilling Company

Sec. 3-32-15W
Barber County
Kansas

Commenced: August 26, 1957
Completed: Sept. 11, 1957

Elevation: 1981 RB

	<u>From</u>	<u>To</u>	<u>Remarks</u>
Sand	0	70	Set 8 5/8" surface pipe @ 200' w/170 sacks cement
Red Rock w/streaks of Gyp	70	370	
Red Bed & Rock	370	1000	Geological Tops: Elec. Log:
Red Rock & Red Bed	1000	1125	
Salt	1125	1109	Algin Sand None
Shale & Shells	1185	2180	Hebner Shale 4077 4079
Line & Shale	2180	2345	Base/Creed 4113 4121
Line & Shale w/Anhydrite	2345	2440	Douglas Sand 4140 4141
Line & Shale	2440	2628	Lansing 4259 4268
Shale & Line	2628	2960	Base/Kan. City 4692 4699
Line & Shale	2960	3210	Mississippi 4798 4800
Mostly Shale, some line	3210	3320	RTD 4901 4903
Shale & Line	3320	3685	DST 4000-30 Open 1 hr. Gas to surf. in 2 min., gauged 734,000 in 5 min., dec. to 275,000 CFB after 1 hr. Rec. 50° OCA. FP 135°-75° IHP 1575/30 min. FHP 1125/30 min.
Line & Shale	3685	3830	
Line w/shale	3830	3913	DST 4030-66 Open 30 min. Gas to surf. in 1 1/2 min., gauged 2,830 MCF/5 min., Inc. to 3,000 MCF/10 min., sprayed oil after 25 min. Inc. 150° Adv oil. FP 675°-7.5° IHP 1615/20 min. - FHP 1610/20 min.
Sand, Line & Shale	3913	3974	
Line & Sand	3974	4050	5 1/2" casing @ 4901' w/150 sacks cement.
Line w/sand	4050	4118	
Line & Shale	4118	4193	
Line & Sand	4193	4254	
Line w/shale	4254	4326	
Line	4326	4720	
Line w/shale	4720	4742	
Line	4742	4901 T.O.	

RECEIVED
STATE CORPORATION COMMISSION
AUG 15 1974
8-15-74
CONSERVATION DIVISION
Wichita, Kansas

I hereby certify that this is a true and correct copy of the above log to the best of my knowledge.

Paul W. Hesse

Subscribed and sworn to before me this 25th day of October, 1957

Duane Jessup
DUANE JESSUP
Notary Public

By Commission Expires: December 11, 1957