

STATE OF KANSAS  
STATE CORPORATION COMMISSION

Give All Information Completely  
Make Required Affidavits  
Mail or Deliver Report to:  
Conservation Division  
State Corporation Commission  
211 No. Broadway  
Wichita, Kansas

15-007 - 01822-0000  
WELL PLUGGING RECORD

Barber

County. Sec. 2 Twp. 33S Rge. 15W (E) (W)

Location as "NE/CNW/SW" or footage from lines SE SE NW

Lease Owner West Supply Co., Inc.

Lease Name H. DeGeer Well No. 1

Office Address Box 506 - Chase, Kansas

Character of Well (completed as Oil, Gas or Dry Hole) Oil well

Date well completed August 5 19 48

Application for plugging filed December 11 19 56

Application for plugging approved December 12 19 56


Plugging commenced February 14 19 57

Plugging completed February 20 19 57

Reason for abandonment of well or producing formation Depleted

If a producing well is abandoned, date of last production July 19 56

Was permission obtained from the Conservation Division or its agents before plugging was commenced? Yes

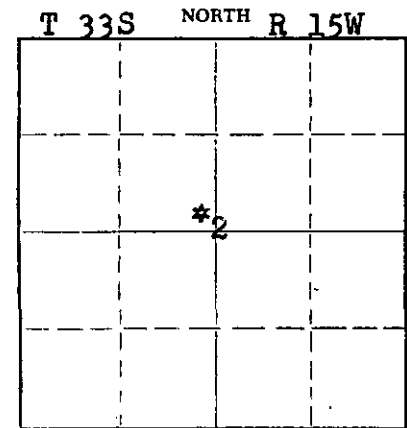

Locate well correctly on above Section Plat

Name of Conservation Agent who supervised plugging of this well Merle Rives

Producing formation \_\_\_\_\_ Depth to top \_\_\_\_\_ Bottom \_\_\_\_\_ Total Depth of Well 5312 Feet

Show depth and thickness of all water, oil and gas formations.

OIL, GAS OR WATER RECORDS

CASING RECORD

FORMATION	CONTENT	FROM	TO	SIZE	PUT IN	PULLED OUT
				10-3/4"	695'	None
				7" OD	889'	3905'
				Well was plugged back to 5272' and perforated from 5209' to 5218'.		

Describe in detail the manner in which the well was plugged, indicating where the mud fluid was placed and the method or methods used in introducing it into the hole. If cement or other plugs were used, state the character of same and depth placed, from \_\_\_\_\_ feet to \_\_\_\_\_ feet for each plug set.

Filled the hole with sand from 5272' to 5190' and ran 5 sacks of cement to 5165'. Circulated the hole with 41 sacks of jell mud at 1400'. Mudded the hole to 300', set a 10' rock bridge and ran 25 sacks of cement. Mudded the hole to 25', set a rock bridge and ran 10 sacks of cement to base of cellar. Plugging completed.

RECEIVED  
STATE CORPORATION COMMISSION

FEB 26 1957

CONSERVATION DIVISION  
Wichita, Kansas

Name of Plugging Contractor West Supply Co., Inc.

Address Chase, Kansas

STATE OF Kansas COUNTY OF Rice, ss.

Noel J. Knight (Signature) or (owner or operator) of the above-described well, being first duly sworn on oath, says: That I have knowledge of the facts, statements, and matters herein contained and the log of the above-described well as filed and that the same are true and correct. So help me God.

(Signature) Noel J. Knight

Chase, Kansas (Address)

SUBSCRIBED AND SWORN TO before me this 27th day of February 19 57

My commission expires May 20, 1957 Edward E. O'Brien Notary Public.

PLUGGING  
FILE SEC 2 T 33 R 15W  
BOOK PAGE 125 LI E 11

WELL LOG BUREAU - KANSAS GEOLOGICAL SOCIETY  
412 Union National Bk. Bldg., Wichita, Kansas


Company - SINCLAIR-PRAIRIE OIL COMPANY  
Farm - H. De Geer No. 1

SEC. 2 T. 33 R. 15W  
SE SE NW

Total Depth. 5312  
Comm. 7-13-48 Comp. 8-5-48  
Shot or Treated.  
Contractor. Harbar Drlg.  
Issued. 3-26-49

County. Barber

KANSAS

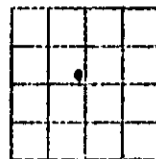

Elevation. \_\_\_\_\_

Production. 5135 oil

CASING:

10 3/4" 695'  
7" 2852'  
5228'

Figures Indicate Bottom of Formations.

sand, gravel	80
red rock, shells	145
red rock, sand, shale	580
sand rock	601
pyrite	608
red rock, limeshells	702
red rock, shale	950
red rock, lime shells	1478
shale, sand, shells	1528
shale, shells	1733
salt, shale	1833
shale, shells	2198
anhydrite, shale	2288
lime, shale	2478
shale, shells	2593
lime, shale	3333
lime brkn	3408
lime	3473
shale, dolomite	3528
lime, shale	4383
lime	4393
lime cherty	4473
lime	4568
lime cherty	4843
lime	4873
lime, shale	5048
lime chert	5300
shale	5304
sand	5305
sand ?	5312
Total depth	

Tops: SJ

Lansing	4313
Mississippi lime	4870
Kinderhook	5058
Viola lime	5182
Simpson	5304

**PLUGGING**  
FILE SEC 2 T 33 R 15W  
BOOK PAGE 125 LINE 11