

Give All Information Completely  
Make Required Affidavit  
Mail or Deliver Report to:  
Conservation Division  
State Corporation Commission  
211 No. Broadway  
Wichita, Kansas

WELL PLUGGING RECORD

BARBER County, Sec. 17 Twp. 32 S Rge. (E) 15 (W)

Location as "NE/CNW/SW" or footage from lines SW-NE of NW

Lease Owner ATLANTIC RICHFIELD COMPANY

Lease Name T. L. WELSH "C" Well No. 1

Office Address BOX 521, Tulsa, Oklahoma

Character of Well (completed as Oil, Gas or Dry Hole) GAS

Date well completed 7-18- 19 60

Application for plugging filed 8-18- 19 75

Application for plugging approved 8-19- 19 75


Plugging commenced 8-24- 19 75

Plugging completed 8-29- 19 75

Reason for abandonment of well or producing formation Depleted

If a producing well is abandoned, date of last production 4-22- 19 75

Was permission obtained from the Conservation Division or its agents before plugging was commenced? YES

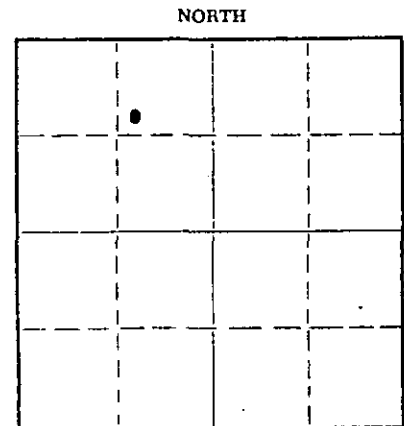

Locate well correctly on above Section Plat

Name of Conservation Agent who supervised plugging of this well Russel Biberstein

Producing formation Mississippi Depth to top 4820 Bottom 4850 Total Depth of Well 4935 Feet

Show depth and thickness of all water, oil and gas formations.

OIL, GAS OR WATER RECORDS

CASING RECORD

FORMATION	CONTENT	FROM	TO	SIZE	PUT IN	PULLED OUT
			0	10 3/4	308	NONE
			0	5 1/2	4930	4014

Describe in detail the manner in which the well was plugged, indicating where the mud fluid was placed and the method or methods used in introducing it into the hole. If cement or other plugs were used, state the character of same and depth placed, from \_\_\_\_\_ feet to \_\_\_\_\_ feet for each plug set.

Pumped in 35 sacks cement plug through perf 4820-4850. Top cement plug at 4700. Shut 5 1/2" csg off at 4585-4238 and 4014, filled hole with mud pulled 128 jts 5 1/2" csg, total 4014. spotted 50 sks cement, plug from 358' up to 258'. Filled hole w/mud from 258 up to 15', spotted 15 sks cement, plug from 15' to surface. Welded plate on top of 10 3/4" csg. Complete P & A at 1:00 PM 8-29-75.

RECEIVED  
STATE CORPORATION COMMISSION

SEP 05 1975  
9-5-75  
CONSERVATION DIVISION  
Wichita, Kansas

(If additional description is necessary, use BACK of this sheet)

Name of Plugging Contractor LILLARD CASING PULLING

Address Box 962, Woodward, Oklahoma

STATE OF OKLAHOMA, COUNTY OF WOODWARD, ss.

Doyle Cheatwood (employee of owner) or (owner or operator) of the above-described well, being first duly sworn on oath, says: That I have knowledge of the facts, statements, and matters herein contained and the log of the above-described well as filed and that the same are true and correct. So help me God.

(Signature) Doyle Cheatwood

ATLANTIC RICHFIELD COMPANY  
1112 11th St, Woodward, Oklahoma

SUBSCRIBED AND SWORN to before me this 4th day of September, 19 75

My Commission Expires 2-28-79

Donna Hale  
DONNA HALE Notary Public.

My commission expires \_\_\_\_\_

15-007-16695-0000

T. L. WELSH "C" NO. 1

NW/4 of Section 17-32S-15W  
Barber County, Kansas  
Sinclair Oil & Gas Company

10-3/4" O. D. casing cemented at 308'  
5-1/2" O. D. casing cemented at 4930'

Drilling commenced 6-28-60  
Drilling completed 7-18-60

FROM	TO	FORMATION	REMARKS
0'	50'	Surface clay	
50	135	Shale & red bed	
135	310	Shale	10-3/4" O. D. casing cemented with 300 sacks at 308'
310	965	Shells & shale	
965	1710	Shale & shells	
1710	1940	Shale	
1940	2150	Shale & shells	
2150	2330	Lime	
2330	2407	Lime & shale	
2407	2480	Lime	
2480	3030	Lime & shale	
3030	3290	Shale & lime	
3290	3800	Lime & shale	
3800	3905	Lime	
3905	3985	Shale, lime & streaks of sand	
3985	4150	Shale & lime	
4150	4180	Shale & sand	
4180	4192	Sand & shale	
4192	4260	Shale	
4260	4664	Lime	
4664	4820	Lime & shale	
4820	4860	Lime & chert	
4860	4901	Lime & shale	
4901	4935	Lime	5-1/2" O. D. casing cemented with 200 sacks at 4930'
T. D.	4935'		

RECEIVED  
STATE CORPORATION COMMISSION

AUG 19 1975  
8-19-75  
CONSERVATION DIVISION  
Wichita, Kansas

This is a true copy of the driller's log as shown on the drilling tickets.

BARBOUR DRILLING COMPANY

By- *E. W. Pribel*

Subscribed and sworn to before me on this 28th day of July, 1960.

*Merry Jane Burt*  
Notary Public

My commission expires  
July 27, 1961.