


STATE OF KANSAS
STATE CORPORATION COMMISSION

WELL PLUGGING RECORD

Give All Information Completely
Make Required Affidavit
Mail or Deliver Report to
Conservation Division
State Corporation Comm.
245 North Water
Wichita, KS 67202

BARBER County. Sec. 17 Twp. 32S Rge 15 E/W
Location as "NE/CNW 1/4 SW 1/4" or footage from lines _____
660 FNL 1650 FEL
Lease Owner TEXAS OIL AND GAS CORPORATION.
Lease Name RUSK Well No. D - 1
Office Address 200 W Douglas, Suite 300, Wichita, Kansas
Character of Well (Completed as Oil, Gas or Dry Hole) _____

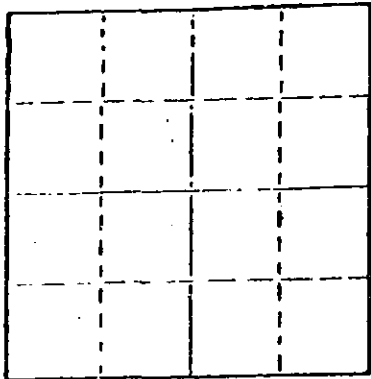

Locate well correctly on above
Section Plot

_____ Dry _____
Date Well completed 7 - 24 1978
Application for plugging filed Nov. 10 1978
Application for plugging approved Nov. 15 1978
Plugging commenced 12 - 1 1978
Plugging completed 12 - 21 1978
Reason for abandonment of well or producing formation _____

If a producing well is abandoned, date of last production _____ 19____

Was permission obtained from the Conservation Division or its agents before plugging was commenced? YES

Name of Conservation Agent who supervised plugging of this well BILL OWENS
Producing formation _____ Depth to top _____ Bottom _____ Total Depth of Well 4835'
Show depth and thickness of all water, oil and gas formations.

OIL, GAS OR WATER RECORDS

CASING RECORD

FORMATION	CONTENT	FROM	TO	SIZE	PUT IN	PULLED OUT
				8 5/8	1017	NONE
				4 1/2"	4801	4060

Describe in detail the manner in which the well was plugged, indicating where the mud fluid was placed and the method or methods used in introducing it into the hold. If cement or other plugs were used, state the character of same and depth placed, from _____ feet to _____ feet for each plug set.

DUMPED SAND FROM 4835 to 4790. 4 SACKS CEMENT FROM 4790 to 4680.

PUMPED 100 SACKS 60-40 Poz.

RECEIVED
STATE CORPORATION COMMISSION

JAN 10 1979

1-10-79

CONSERVATION DIVISION
Wichita, Kansas

(If additional description is necessary, use BACK of this sheet)

Name of Plugging Contractor CLARKE CORPORATION

STATE OF KANSAS COUNTY OF SEDGWICK, ss.
Victor C. Smith of Texas Oil & Gas Corp. (employee of owner) or (owner or operator)
of the above-described well, being first duly sworn on oath, says: That I have knowledge of the facts, statements, and matters herein contained and the log of the above-described well as filed and that the same are true and correct. So help me God.

(Signature) Victor C. Smith
VICTOR C. SMITH of Texas Oil & Gas Corp.
200 W. Douglas, (Address) Suite 300, Wichita,

SUBSCRIBED AND SWORN TO before me this 9th day of January, 1979. KS 67202

Elizabeth A. Cauley
ELIZABETH A. CAULEY Notary Public.

My commission expires January 23, 1980



KANSAS DRILLERS LOG

COMPANY Texas Oil & Gas Corp.

SEC. 17 T. 32S R. 15W
LOC. 660' FNL & 1,650' FEL

FARM Rusk "D"

NO. 1 OWWO

COUNTY Barber

ROTARY TOTAL DEPTH 4,835'
COMM. July 11, 1978
CONTRACTOR H-30, Inc.
ISSUED July 24, 1978

COMP. July 16, 1978

CASING

10 3/4"
8 5/8" Set at 1,017' by prior operator
5 1/2"
4 1/2" Set at 4,801' cemented w/125 sxs cement

ELEVATION 1,949 K.B.

FIGURES INDICATE BOTTOM OF FORMATIONS

Old Rotary Total Depth	4,835'
Washed down to	4,835'
Rotary Total Depth	4,835'

I hereby certify the above and foregoing to be a true and correct log of the above described well as shown by the drilling reports.

H-30, Inc.

Dean Britting
Dean Britting

State of Kansas }
County of Sedgwick } ss:

Subscribed and Sworn to before me a Notary Public in and for said county and state this 24th day of July, 1978.



Elsie Willison
Elsie Willison - Notary Public

My Commission Expires:

June 30, 1982

RECEIVED
STATE CORPORATION COMMISSION

NOV 13 1978
11-13-78
CONSERVATION DIVISION
Wichita, Kansas