

15-007-01451-0000


STATE OF KANSAS
STATE CORPORATION COMMISSION

Give All Information Completely
Make Required Affidavit
Mail or Deliver Report to:
Conservation Division
State Corporation Commission
212 North Market, Insurance Bldg.
Wichita, Kansas

WELL PLUGGING RECORD

Barber County. Sec. 17 Twp. 32S Rge. (E) 15 (W)

Location as "NE/CNW/SW" or footage from lines NE/4 SE/4 SW/4
Lease Owner Messman-Rinehart Oil Company
Lease Name Moore's Well No. 1
Office Address 518 Petroleum Building, Wichita, Kansas
Character of Well (completed as Oil, Gas or Dry Hole) Dry Hole
Date well completed January 22 1961
Application for plugging filed January 22 1961
Application for plugging approved January 22 1961
Plugging commenced January 22 1961
Plugging completed January 22 1961
Reason for abandonment of well or producing formation Dry

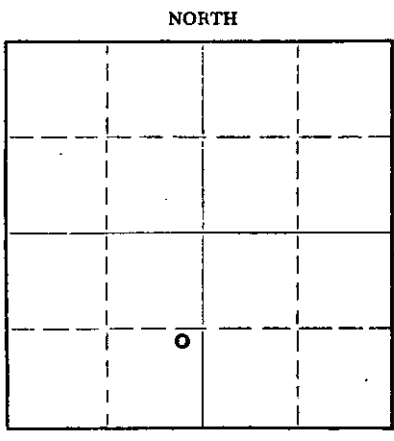

Locate well correctly on above Section Plat

If a producing well is abandoned, date of last production _____ 19____
Was permission obtained from the Conservation Division or its agents before plugging was commenced? yes

Name of Conservation Agent who supervised plugging of this well Fred W. Hampel, Pretty Prairie, Kansas
Producing formation _____ Depth to top _____ Bottom _____ Total Depth of Well 4860 Feet
Show depth and thickness of all water, oil and gas formations.

OIL, GAS OR WATER RECORDS

CASING RECORD

FORMATION	CONTENT	FROM	TO	SIZE	PUT IN	PULLED OUT
				10-3/4"	207'	none

Describe in detail the manner in which the well was plugged, indicating where the mud fluid was placed and the method or methods used in introducing it into the hole. If cement or other plugs were used, state the character of same and depth placed, from _____ feet to _____ feet for each plug set.

Set plug at 200 ft. with 1/2 sk. hulls and 20 sx. cement. Set second plug at 30 ft. with 1/2 sk. hulls and 10 sx. cement. Mud to surface.

RECEIVED
STATE CORPORATION COMMISSION
MAR 3 1961
3-3-61
CONSERVATION DIVISION
Wichita, Kansas

(If additional description is necessary, use BACK of this sheet)
Name of Plugging Contractor Messman-Rinehart Oil Company
Address 518 Petroleum Building, Wichita, Kansas

STATE OF Kansas, COUNTY OF Sedgwick, ss.

(employee of owner) or (owner or operator) of the above-described well, being first duly sworn on oath, says: That I have knowledge of the facts, statements, and matters herein contained and the log of the above-described well as filed and that the same are true and correct. So help me God.

(Signature) [Signature]
518 Petroleum Building, Wichita, Kansas
(Address)

SUBSCRIBED AND SWORN TO before me this 1st day of February, 1961

My commission expires December 1, 1964
Barbara J. Scott
Notary Public.

NO. 1 MOORESWell Record:

Location: NE/4 SE/4 SW/4, Sec. 17-32S-15W
Barber County, Kansas

Contractor: Messman-Rinehart Oil Company
518 Petroleum Building
Wichita, Kansas

Contractor: Messman-Rinehart Oil Company
518 Petroleum Building
Wichita, Kansas

Commenced: January 7, 1961

Completed: January 22, 1961

Elevation: 1874' R/B

Production D & A

Casing Record: 10-3/4" @ 207' w/175 sx. cem.

*** LOG ***

Clay & Red Bed	75
Gyp Rock	100
Red Bed & Shale	1140
Anhydrite	1165
Shale	1565
Shale, Shells & Salt	1860
Anhydrite	1880
Shale w/Lime Streaks	2025
Lime & Shale	2295
Lime	2785
Lime & Shale	3780
Shale & Lime	3830
Lime & Shale	4225
Lime	4535
Lime & Chert	4575
Lime	4738
Miss. Chert	4755
Chert	4810
Lime & Chert	4845
Chert & Lime	4860 R.T.D.

Sample Tops:

4024' - Heebner (-2150)
4086' - Douglas Sand (-2212)
4194' - Lansing (-2320)
4738' - Mississippian (-2864)

RECEIVED
STATE CORPORATION COMMISSION

MAR 5 1961
3-3-61
CONSERVATION DIVISION
Wichita, Kansas

The undersigned, MESSMAN-RINEHART OIL COMPANY, hereby certifies that the above log is a true and correct log of the formation encountered in drilling the above well as reflected by the Daily Drilling Reports.

MESSMAN-RINEHART OIL COMPANY

By: J. A. Gilliland

J. A. Gilliland

Subscribed and sworn to before me this
1st day of February, 1961.

By: Barbara J. Scott

Barbara J. Scott, Notary Public

My Commission Expires: December 1, 1964