


STATE OF KANSAS  
STATE CORPORATION COMMISSION  
CONSERVATION DIVISION  
P. O. BOX 17027  
WICHITA, KANSAS 67217

FORM CP-4

WELL PLUGGING RECORD

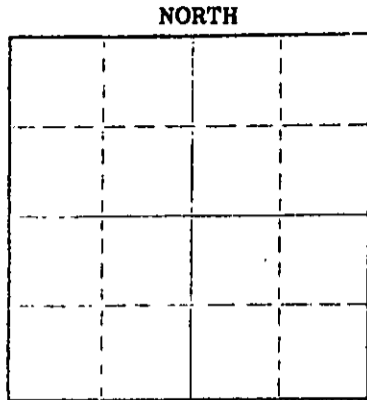

Locate well correctly on above Section Plot

Barber County. Sec. 34 Twp. 34 Rge. 14 (E) (W)  
Location as "NE/CNW/SW" or footage from lines 150' NC NW SW SW  
Lease Owner Cities Service Oil Co.  
Lease Name Baier D Well No. 1  
Office Address 700 Sutton Place Bldg., Wichita, Kansas  
Character of Well (completed as Oil, Gas or Dry Hole) Dry Hole  
Date well completed 19\_\_\_\_  
Application for plugging filed 7/7 19 76  
Application for plugging approved 7/7 19 76  
Plugging commenced 7/7 19 76  
Plugging completed 7/7 19 76  
Reason for abandonment of well or producing formation Dry Hole

If a producing well is abandoned, date of last production 19\_\_\_\_  
Was permission obtained from the Conservation Division or its agents before plugging was commenced? yes

Name of Conservation Agent who supervised plugging of this well \_\_\_\_\_  
Producing formation \_\_\_\_\_ Depth to top \_\_\_\_\_ Bottom \_\_\_\_\_ Total Depth of Well 4955 Feet  
Show depth and thickness of all water, oil and gas formations.

OIL, GAS OR WATER RECORDS

CASING RECORD

| FORMATION | CONTENT | FROM | TO | SIZE  | PUT IN | PULLED OUT |
|-----------|---------|------|----|-------|--------|------------|
|           |         |      |    | 8-5/8 | 400'   | none       |
|           |         |      |    |       |        |            |
|           |         |      |    |       |        |            |
Describe in detail the manner in which the well was plugged, indicating where the mud fluid was placed and the method or methods used in introducing it into the hole. If cement or other plugs were used, state the character of same and depth placed, from \_\_\_\_\_ feet to \_\_\_\_\_ feet for each plug set.

Plug with 50 sacks cement 420' to 290' Put in bridge at 40'  
10 sacks cement 40' to bottom cellar 2 sacks cement in rat hole.

STATE CORPORATION COMMISSION  
7-20-76  
JUL 20 1976  
CONSERVATION DIVISION  
WICHITA, KANSAS

(If additional description is necessary, use BACK of this sheet)  
Name of Plugging Contractor Gabbert & Jones  
Address 830 Sutton Place Bldg., Wichita, Kansas 67202

STATE OF Kansas COUNTY OF Sedgwick  
William J. Devaney (employee of owner) or (owner/operator) of the above-described

well, being first duly sworn on oath, says: That I have knowledge of the facts, statements, and matters herein contained and the log of the above-described well as filed and that the same are true and correct. So help me God.

Glenn E. Meier  
STATE NOTARY PUBLIC  
Sedgwick County, Kansas

(Signature) [Signature]  
209 E. William, Wichita, KS 67202  
(Address)

Subscribed and sworn to before me this 16th day of July 19 76

My commission expires June 3, 1977  
Glenn E. Meier Notary Public

15-007-20425-0000  
GABBERT-JONES, INC.  
WICHITA, KANSAS  
DRILLERS' WELL LOG

RECEIVED  
STATE COMMISSION  
JUL 20 1976  
7-20-76  
CONSERVATION DIVISION  
WICHITA, KANSAS

Baier D #1  
Sec 34-34S-14W  
Barber County Kansas

Commenced: 6-24-76

Completed: 7-7-76

OPERATOR: CITIES SERVICE OIL CO.

| Depth |           | Formation    | Remarks                |
|-------|-----------|--------------|------------------------|
| From  | to        |              |                        |
| 0     | 455       | Rock-Redbed  | Ran 10 jts of New 24#  |
| 455   | 1225      | Shale-Shells | 8 5/8" csg set @ 400'  |
| 1225  | 1840      | Shale        | Cemented w/300 sbs     |
| 1840  | 2486      | Shale-Lime   | Common 50/50 Posmix CC |
| 2486  | 3105      | Lime-Shale   | 2% PD @ 11:40 a.m.     |
| 3105  | 3260      | Shale-Lime   | 6-25-76                |
| 3260  | 4130      | Lime-Shale   |                        |
| 4130  | 4955      | Lime         |                        |
|       | 4955 - TD |              | DRY & ABANDONED        |

STATE OF KANSAS )  
                          ) SS  
COUNTY OF SEDGWICK)

I, the undersigned, being duly sworn on oath, state that the above Drillers Log is true and correct to the best of my knowledge and belief and according to the records of this office.

GABBERT-JONES, INC.

*James S. Sutton II*  
JAMES S. SUTTON II

Subscribed and sworn to before me this 14th day of July, 1976.

*Elizabeth J. Edwards*  
ELIZABETH J. EDWARDS-NOTARY PUBLIC

My Commission Expires February 6, 1979.

