

15-007-20016-0000

STATE OF KANSAS  
STATE CORPORATION COMMISSION


WELL PLUGGING RECORD

Give All Information Completely  
Make Required Affidavit  
Mail or Deliver Report to:  
Conservation Division  
State Corporation Commission  
211 No. Broadway  
Wichita, Kansas

Barber County, Sec. 36 Twp. 34S Rge. 14W (E) (W)

Location as "NE/CNW/SW" or footage from lines C SW SW SW  
Lease Owner K & E Drilling, Inc.  
Lease Name George Baier Well No. 1  
Office Address 719 Union Center, Wichita, Kansas  
Character of Well (completed as Oil, Gas or Dry Hole) Dry Hole  
Date well completed 4/29 19 67  
Application for plugging filed 4/29 19 67  
Application for plugging approved 4/29 19 67  
Plugging commenced 4/29 19 67  
Plugging completed 4/29 19 67  
Reason for abandonment of well or producing formation Dry

NORTH

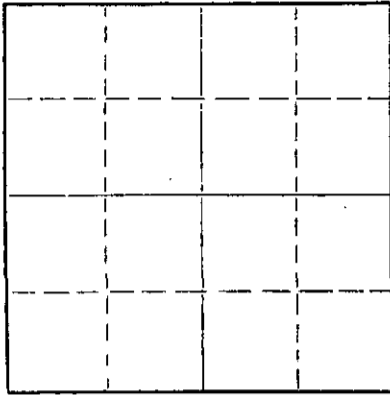

Locate well correctly on above  
Section Plat

If a producing well is abandoned, date of last production 19  
Was permission obtained from the Conservation Division or its agents before plugging was commenced? Yes

Name of Conservation Agent who supervised plugging of this well A. Elving, Pratt, Kansas  
Producing formation Depth to top Bottom Total Depth of Well 4825 Feet  
Show depth and thickness of all water, oil and gas formations.

OIL, GAS OR WATER RECORDS

CASING RECORD

FORMATION	CONTENT	FROM	TO	SIZE	PUT IN	PULLED OUT
				8-5/8"	333'	0

Describe in detail the manner in which the well was plugged, indicating where the mud fluid was placed and the method or methods used in introducing it into the hole. If cement or other plugs were used, state the character of same and depth placed, from feet to feet for each plug set.

Heavy mud to 300'. 1/2 sx. hulls, 25 sx. dry cement.  
Heavy mud to 40' - Solid Bridge. 10 sx. cement.  
Plugging completed at 4:00 P.M.

RECEIVED  
STATE CORPORATION COMMISSION

MAY 5 1967  
5-5-67

CONSERVATION DIVISION  
Wichita, Kansas

(If additional description is necessary, use BACK of this sheet)

Name of Plugging Contractor K & E Drilling, Inc.  
Address 719 Union Center, Wichita, Kansas

STATE OF KANSAS, COUNTY OF SEDGWICK ss.  
H. L. Wilson (employee of owner) or (owner/director) of the above-described well, being first duly sworn on oath, says: That I have knowledge of the facts, statements, and matters herein contained and the log of the above-described well as filed and that the same are true and correct. So help me God.

(Signature) H. L. Wilson  
719 Union Center, Wichita, Kansas  
(Address)

SUBSCRIBED AND SWORN TO before me this 4th day of May, 1967

My commission expires 9-14-70 Jodie K. Eby Notary Public.



# DRILLER'S WELL LOG

OPERATOR: K & E DRILLING, INC.  
719 Union Center  
Wichita, Kansas 67202

WELL NAME: #1 George Baier  
LOCATION: C SW SW SW  
Sec. 36-34S-14W  
Barber County, Kansas

CONTRACTOR: **K & E DRILLING, INC.**  
719 UNION CENTER BLDG.  
WICHITA, KANSAS

COMMENCED: 4/17/67  
COMPLETED: 4/29/67  
ELEVATION: 1582' KB; 1579' DF;  
1573' Grd.  
PRODUCTION: Dry

CASING RECORD:  
8-5/8" @ 333' w/250 sx.

ROTARY TOTAL DEPTH: 4825'

## FORMATION RECORD

*Depths shown indicate bottom of formations encountered.*

Soil - Red Beds	333
Shale	1365
Shale & Shells	1875
Lime - Anhydrite	2030
Lime	2762
Shale & Lime	2982
Lime	4825

**RECEIVED**  
STATE CORPORATION COMMISSION

MAY 5 1967  
5-5-67

CONSERVATION DIVISION  
Wichita, Kansas

## CERTIFICATION

State of KANSAS }  
County of SEDGWICK } ss:

I, H. L. Wilson, of K&E DRILLING, INC., upon oath state that the above and foregoing is a true and correct copy of the Driller's Log of the above named well.

H. L. Wilson H. L. Wilson

Subscribed and sworn to before me this 4th day of May, 19 67.

Judie K. Eby  
Judie K. Eby Notary Public.

My Commission expires: 9-14-70

