

STATE OF KANSAS
STATE CORPORATION COMMISSION


Give All Information Completely
Make Required Affidavit
Mail or Deliver Report to:
Conservation Division
State Corporation Commission
211 No. Broadway
Wichita, Kansas

WELL PLUGGING RECORD

Barber County, Sec. 36 Twp. 34S Rge. 14W (E) (W)

Location as "NE/CNW/SW" or footage from lines 150' N of NE NW SW
Lease Owner Publishers Petroleum
Lease Name Baier Unit Well No. 1
Office Address c/o Oklahoma Publishing Co., Oklahoma City, Okla.
Character of Well (completed as Oil, Gas or Dry Hole) Dry Hole
Date well completed February 22 19 63
Application for plugging filed February 22 (verbal) 19 63
Application for plugging approved February 22 (verbal) 19 63
Plugging commenced February 22 19 63
Plugging completed February 22 19 63
Reason for abandonment of well or producing formation Dry hole

NORTH

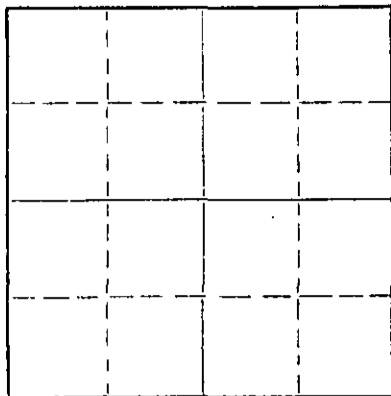

Locate well correctly on above
Section Plat

If a producing well is abandoned, date of last production _____ 19____
Was permission obtained from the Conservation Division or its agents before plugging was com-
menced? yes

Name of Conservation Agent who supervised plugging of this well _____
Producing formation Mississippi Lime Depth to top _____ Bottom _____ Total Depth of Well 4900 Feet
Show depth and thickness of all water, oil and gas formations.

OIL, GAS OR WATER RECORDS

CASING RECORD

FORMATION	CONTENT	FROM	TO	SIZE	PUT IN	PULLED OUT
				8-5/8"	325	none

Describe in detail the manner in which the well was plugged, indicating where the mud fluid was placed and the method or methods used in introducing it into the hole. If cement or other plugs were used, state the character of same and depth placed, from 135 feet to 250 feet for each plug set.

With 35 sacks cement. Then placed wooden plug at 50' and filled to surface with cement on February 22, 1963

RECEIVED
STATE CORPORATION COMMISSION

MAR 18 1963

3-18-63

CONSERVATION DIVISION
Wichita, Kansas

(If additional description is necessary, use BACK of this sheet)

Name of Plugging Contractor Davon Drilling Company
Address P. O. Box 1586, Oklahoma City 1, Oklahoma

STATE OF Oklahoma COUNTY OF Oklahoma ss.
A. L. Tate, Vice-President (employee of owner) or (owner or operator) of the above-described well, being first duly sworn on oath, says: That I have knowledge of the facts, statements, and matters herein contained and the log of the above-described well as filed and that the same are true and correct. So help me God.

(Signature) A. L. Tate
P. O. Box 1586, Oklahoma City, Oklahoma
(Address)

SUBSCRIBED AND SWORN to before me this 12th day of March, 19 63

My commission expires Oct. 22, 1963

Notary Public.



FORMATION LOG
Baier Unit #-1
NE NW SW 36-34S-14W
Barber County, Kansas

Publishers Petroleum Company
Operator

Davon Drilling Company
Contractor

0-1235	Red Bed & Shale
2473	Shale & Anhydrite
2605	Sand & Lime
2884	Shale & Lime
3041	Shale
4232	Shale & Lime
4567	Lime
4600	Lime & Chert
4641	Lime & Shale
4900	Lime

Spud	2-6-63
Comp.	2-22-63

RECEIVED
STATE CORPORATION COMMISSION

MAR 18 1963
3-18-63
CONSERVATION DIVISION
Wichita, Kansas