


STATE OF KANSAS  
STATE CORPORATION COMMISSION

WELL PLUGGING RECORD

Give All Information Completely  
Make Required Affidavit  
Mail or Deliver Report to:  
Conservation Division  
State Corporation Commission  
800 Biting Building  
Wichita, Kansas

Barber County, Sec. 3 Twp. 34S Rge. (E) 12 (W)

NORTH

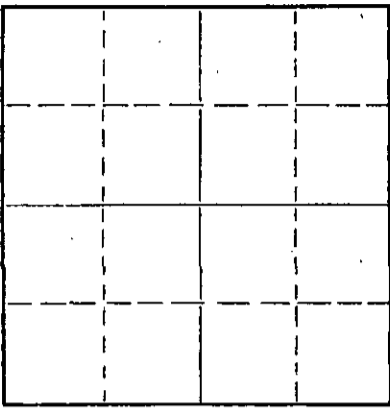

Locate well correctly on above  
Section Plat

Location as "NE/CNW/SW" or footage from lines \_\_\_\_\_  
Lease Owner Jones, Shelburne & Farmer, Inc.  
Lease Name Wright Well No. 1  
Office Address Russell, Kansas  
Character of Well (completed as Oil, Gas or Dry Hole) Dry  
Date well completed 3-13 19 55  
Application for plugging filed 3-13 19 55  
Application for plugging approved 3-13 19 55  
Plugging commenced 3-13 19 55  
Plugging completed 3-13 19 55  
Reason for abandonment of well or producing formation Dry

If a producing well is abandoned, date of last production \_\_\_\_\_ 19 \_\_\_\_\_  
Was permission obtained from the Conservation Division or its agents before plugging was commenced? \_\_\_\_\_

Name of Conservation Agent who supervised plugging of this well Ruel Durkee  
Producing formation \_\_\_\_\_ Depth to top \_\_\_\_\_ Bottom \_\_\_\_\_ Total Depth of Well 5346 Feet  
Show depth and thickness of all water, oil and gas formations.

OIL, GAS OR WATER RECORDS

CASING RECORD

FORMATION	CONTENT	FROM	TO	SIZE	PUT IN	PULLED OUT
				8-5/8	265'	None

Describe in detail the manner in which the well was plugged, indicating where the mud fluid was placed and the method or methods used in introducing it into the hole. If cement or other plugs were used, state the character of same and depth placed, from \_\_\_\_\_ feet to \_\_\_\_\_ feet for each plug set.

- Filled hole to 250' with heavy mud
- Halliburton plug pushed to 250' and 1/2 sack hulls dumped on top of plug
- 20 sacks cement mixed and spotted on top of hulls by Halliburton
- Hole filled to 40' with heavy mud
- 2nd Halliburton plug pushed to 40'
- 1/2 sack of hulls dumped on top of plug
- Hole filled to top with 10 sacks cement

3-23-55  
CONSERVATION DIVISION  
WICHITA, KANSAS

(If additional description is necessary, use BACK of this sheet)  
Name of Plugging Contractor Jones, Shelburne & Farmer, Inc.  
Address Russell, Kansas

STATE OF Kansas, COUNTY OF Russell, ss.  
John O. Farmer (employee of owner) or (owner or operator) of the above-described well; being first duly sworn on oath, says: That I have knowledge of the facts, statements, and matters herein contained and the log of the above-described well as filed and that the same are true and correct. So help me God.

(Signature) John O. Farmer  
Russell, Kansas  
(Address)

SUBSCRIBED AND SWORN TO before me this 22nd day of March, 19 55

My commission expires October 11, 1958  
Lucille Hanes Notary Public.


PLUGGING  
FILE SEC 3 T 34 R 12W  
BOOK PAGE 104 LINE 12

OPERATOR Jones, Shelburne & Farmer, Inc.

FORMATION RECORD

ADDRESS Russell, Kansas

Give detailed description and thickness of all formations drilled through, contents of sand, whether dry, water, oil or gas.

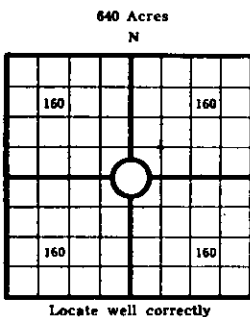

COUNTY Barber SEC. 3 TWP. 34 RGE. 12  
 COMPANY OPERATING Jones, Shelburne & Farmer, Inc.  
 OFFICE ADDRESS Russell, Kansas  
 FARM NAME Wright WELL NO. 1  
 DRILLING STARTED 2-16-55 DRILLING FINISHED 3-13-55  
 DATE OF FIRST PRODUCTION \_\_\_\_\_ COMPLETED \_\_\_\_\_  
 WELL LOCATED NW 1/4 NW 1/4 NE 1/4 North of South  
 Line and \_\_\_\_\_ ft. East of West Line of Quarter Section  
 Elevation (Relative to sea level) DERRICK FLOOR 1495 GROUND 1490  
 CHARACTER OF WELL (Oil, gas or dryhole) Dry

OIL OR GAS SANDS OR ZONES

Name	From	To	Name	From	To
1			4		
2			5		
3			6		

Perforating Record If Any

Shot Record

Formation	From	To	No. of Shots	Formation	From	To	Size of Shot

CASING RECORD

Amount Set						Amount Pulled		Packer Record			
Size	Wt.	Thds.	Make	Ft.	In.	Ft.	In.	Size	Length	Depth Set	Make
8-5/8				260							

Liner Record: Amount \_\_\_\_\_ Kind \_\_\_\_\_ Top \_\_\_\_\_ Bottom \_\_\_\_\_

CEMENTING AND MUDDING

Size	Amount Set		Sacks Cement	Chemical		Method of Cementing	Amount	Mudding Method	Results (See Note)
	Ft.	In.		Gal.	Make				
8-5/8	260		175						

Note: What method was used to protect sands if outer strings were pulled? \_\_\_\_\_

NOTE: Were bottom hole plugs used? \_\_\_\_\_ If so, state kind, depth set and results obtained \_\_\_\_\_

TOOLS USED

Rotary Tools were used from \_\_\_\_\_ feet to \_\_\_\_\_ feet. Cable tools were used from \_\_\_\_\_ feet to \_\_\_\_\_ feet, and from \_\_\_\_\_ feet to \_\_\_\_\_ feet, and from \_\_\_\_\_ feet to \_\_\_\_\_ feet.

Type Rig \_\_\_\_\_

INITIAL PRODUCTION TEST

Describe initial test: whether by flow through tubing or casing or by pumping \_\_\_\_\_

Amount of Oil Production \_\_\_\_\_ bbls. Size of choke, if any \_\_\_\_\_ Length of test \_\_\_\_\_ Water

Production \_\_\_\_\_ bbls. Gravity of oil \_\_\_\_\_ Type of Pump if pump is used, describe \_\_\_\_\_

Formation	Top	Bottom	Formation	Top	Bottom
Red Bed	0	200			
Red Bed & shale & shells	200	685			
Shale & shells	685	900			
Shale & lime streaks	900	1125			
Shale & shells	1125	1675			
Shale & lime	1675	1830			
Lime & shale	1830	2410			
Shale & Lime	2410	3610			
Sand Elgin	3610	3660			
Shale & Lime	3660	3735			
Lime & shale	3735	4185			
Shale & lime	4185	4210			
Lime	4210	4570			
Lime & shale	4570	4657			
Cherty Lime	4657	4700			
Lime & shale	4700	5075			
Lime	5075	5346			
			Elgin	3528	
			Heebner		3735
			Douglas		3805
			Lansing		3950
			Kansas City		4107
			Base of K.C.		4453
			Mississippian		4613
			Kinderhook		4848
			Misener		5011
			Maquoketa		5025
			Viola		5051
			Simpson		5121
			Arbuckle		5296
			T.D.		5346

2-23-55

3-12-55  
3-13-55  
4-1-55  
4-2-55  
5-1-55  
5-2-55  
TOPS:

I, the undersigned, being first duly sworn upon oath, state that this well record is true, correct and complete according to the records of this office and to the best of my knowledge and belief.

*John Farmer* Vice-Pres.  
Name and title of representative of company

Subscribed and sworn to before me this 17th day of March, 1955  
 My Commission expires 10-11-58

*Quillie Handy*  
Notary Public

15-057-0016-0000  
WELL NO. 1 COUNTY Barber TWP. 34 RGE. 12  
FARM NAME Wright