

15-007-30141-0000

Give All Information Completely
Make Required Affidavit
Mail or Deliver Report to:
Conservation Division
State Corporation Commission
211 No. Broadway
Wichita, Kansas

WELL PLUGGING RECORD

Barber County, Sec. 4 Twp. 34S Rge. 12 (E) (W)

Location as "NE/CNW&SW%" or footage from lines SW/4 SW/4

Lease Owner Amerada Petroleum Corporation

Lease Name Gladys Warwick #1 Well No. 1

Office Address P. O. Box 2040, Tulsa, Oklahoma

Character of Well (completed as Oil, Gas or Dry Hole) Dry Hole

Date well completed 11-21 1965

Application for plugging filed 11-21 1965

Application for plugging approved 11-21 1965


Plugging commenced 11-21 1965

Plugging completed 11-21 1965

Reason for abandonment of well or producing formation Dry Hole

If a producing well is abandoned, date of last production _____ 19__

Was permission obtained from the Conservation Division or its agents before plugging was commenced? Yes

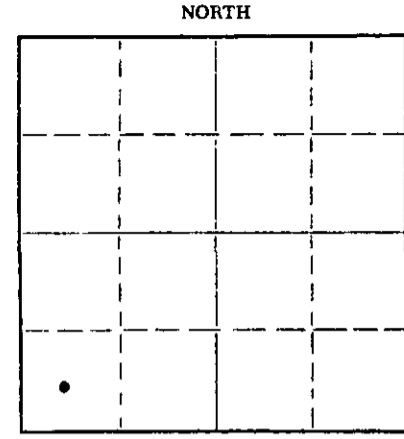

Locate well correctly on above
Section Plat

Name of Conservation Agent who supervised plugging of this well Archie Elving

Producing formation _____ Depth to top _____ Bottom _____ Total Depth of Well _____ Feet

Show depth and thickness of all water, oil and gas formations.

OIL, GAS OR WATER RECORDS

CASING RECORD

FORMATION	CONTENT	FROM	TO	SIZE	PUT IN	PULLED OUT
				8-5/8"	395'	None

Describe in detail the manner in which the well was plugged, indicating where the mud fluid was placed and the method or methods used in introducing it into the hole. If cement or other plugs were used, state the character of same and depth placed, from _____ feet to _____ feet for each plug set.

4780 - 300' Heavy rotary mud
 300' HB plug, 25 sacks cement
 300 - 40' Heavy rotary mud
 40 - GL HB plug, 10 sacks cement, 1/2 sack hulls

RECEIVED
STATE CORPORATION COMMISSION

DEC 2 1965
12-2-65
CONSERVATION DIVISION
Wichita, Kansas

(If additional description is necessary, use BACK of this sheet)

Name of Plugging Contractor Peel Brothers, Inc.

Address P. O. Box 359, Hoisington, Kansas

STATE OF Kansas, COUNTY OF Barton, ss.

Peel Brothers, Inc. (employee of owner) or (owner or operator) of the above-described well, being first duly sworn on oath, says: That I have knowledge of the facts, statements, and matters herein contained and the log of the above-described well as filed and that the same are true and correct. So help me God. PEEL BROTHERS, INC.

(Signature) Wendell C. Peel
Wendell C. Peel, President
Box 359, Hoisington, Kansas
(Address)

SUBSCRIBED AND SWORN to before me this 24th day of November, 1965

My commission expires 6-21-66

Ethel S. Williamson
Ethel S. Williamson Notary Public.

DRILLER'S LOG

Well Owner: Amerada Petroleum Corporation
 Farm Name: Gladys Warwick #1
 Date Started: 11-6-65
 Date Completed: 11-21-65
 Total Depth: 4780

SW/4 SW/4
 Section 4-34S-12W
 Barber County, Kansas

Casing: 8-5/8" set at 405 feet cemented

CONTRACTOR: Peel Brothers, Inc.

Figures below show bottoms of formations:

Red Rock and Clay	0	- 50
Shale and Shells		1910
Shale		2075
Shale and Lime		3205
Sandy Shale		3690
Lime and Shale		3985
Lime		4780
Total Depth		4780

This is to certify that the above information is to the best of our knowledge true and correct.

PEEL BROTHERS, INC.

Wendell C. Peel
 Wendell C. Peel
 President

SUBSCRIBED AND SWORN to before me this 23rd day of November, 1965.

Ethel S. Williamson
 Ethel S. Williamson
 Notary Public

My commission expires 6-21-66

RECEIVED

DEC -2 1965

12-2-65