


WELL PLUGGING RECORD

Give All Information Completely
Make Required Affidavit
Mail or Deliver Report to:
Conservation Division
State Corporation Commission
211 No. Broadway
Wichita, Kansas

NORTH

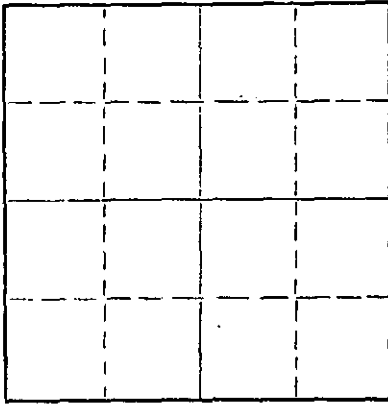

Locate well correctly on above
Section Plat

Barber County, Sec. 6 Twp. 34 S Rge. (E) 12 (W)
Location as "NE/CNW/SW" or footage from lines NE SW SW
Lease Owner Aylward Drilling Company
Lease Name Donovan "B" Well No. 1
Office Address 909 First National Bank Bldg., Wichita, Kansas
Character of Well (completed as Oil, Gas or Dry Hole) Gas
Date well completed March 5, 19 56
Application for plugging filed September 23, 19 65
Application for plugging approved September 23, 19 65
Plugging commenced September 23, 19 65
Plugging completed September 27, 19 65
Reason for abandonment of well or producing formation depleted

If a producing well is abandoned, date of last production August 17 19 65
Was permission obtained from the Conservation Division or its agents before plugging was commenced? Yes

Name of Conservation Agent who supervised plugging of this well A. Elving
Producing formation Mississippian Depth to top Bottom Total Depth of Well 4723 Feet
Show depth and thickness of all water, oil and gas formations.

OIL, GAS OR WATER RECORDS

CASING RECORD

FORMATION	CONTENT	FROM	TO	SIZE	PUT IN	PULLED OUT
				8 5/8"	195'	None
				5 1/2"	4723'	1920'

Describe in detail the manner in which the well was plugged, indicating where the mud fluid was placed and the method or methods used in introducing it into the hole. If cement or other plugs were used, state the character of same and depth placed, from feet to feet for each plug set.

Plugged with sand from 4660-4705'
5 sacks cement from 4625-4660'
Rock bridge from 215-195'
25 sacks cement from 195-140'
Mud from 140-35'
Rock from 35-25'
10 sacks cement to top.

RECEIVED
STATE CORPORATION COMMISSION
OCT 21 1965
10-21-65
CONSERVATION DIVISION
WICHITA, KANSAS

(If additional description is necessary, use BACK of this sheet)
Name of Plugging Contractor Clarke Oilfield Service, Inc.
Address Chapin Building, Medicine Lodge, Kansas 67104

STATE OF KANSAS, COUNTY OF SEDGWICK, ss.
Duane Jessup (employee of owner) of the above-described well, being first duly sworn on oath, says: That I have knowledge of the facts, statements, and matters herein contained and the log of the above-described well as filed and that the same are true and correct. So help me God.

(Signature) Duane Jessup
909 1st Nat'l Bank Bldg., Wichita, Kansas 67202
(Address)

SUBSCRIBED AND SWORN to before me this 20th day of October, 19 65

My commission expires May 14, 1968

Joseph A. Hess
JOSEPH A. HESS
Notary Public.

DONOVAN "B" #1

Casing Records:
8 5/8" - 195'
5 1/2" - 4723'

Company: Aylward Drilling Company
Contractor: Aylward Drilling Company
Commenced: February 21, 1956
Completed: March 5, 1956

Location: NE SW SW
Sec. 6-34-12N
Barber County
Kansas
Elev. 1557 R.B.

	<u>From</u>	<u>To</u>	<u>Remarks</u>
Red Bed	0	60	Set 8 5/8" casing @ 195' w/150 sx Set 5 1/2" " @ 4723' w/100 sx
Red Bed, Sand	60	160	
Red Bed, Shale	160	770	
Red Rock, Lime, Shale, Shells	770	1370	
Salt, Red Rock, Shale	1370	1775	
Lime, Shale Streaks	1775	1946	DST 4660-90', open 1 hr., gas in 3 min. - 1,890,000 cu.ft., BHP 1690, FP 370-520
Lime, Shale	1946	2205	
Shale	2205	2215	
Lime, Shale	2215	2305	DST 4690-4713', open 45 min., gas in 1 min. 3,970,000 cu. ft., BHP 1720#, FP 970-1000.
Shale, Little Lime	2305	2520	
Lime, Shale	2520	2613	
Shale	2613	2735	
Shale, Little Lime	2735	2940	<u>Geological Tops:</u>
Lime, Shale	2940	3275	
Lime	3275	3310	Elgin Sand 3608
Lime, Shale	3310	3340	Heebner 3796
Lime	3340	3370	Lansing 3998
Lime, Shale	3370	3553	Mississippian 4660
Sand	3553	3750	
Lime, Shale	3750	3896	
Shale, Sand	3896	4023	<u>Cable Tool Data:</u>
Lime, Shale	4023	4090	
Lime	4090	4206	Perforated 135 holes 4678-4705 Sandfrac with 10,000# sand, 10,000 gal. Petrojel; swab load, test 21,500,000 cu. ft. per day.
Broken Lime	4206	4279	
Lime	4279	4310	
Lime, some shale	4310	4380	
Lime	4380	4425	
Lime, Shale	4425	4471	
Lime	4471	4502	
Lime, Shale	4502	4665	
Mississippian	4665	4723 T.D.	

RECEIVED
STATE CORPORATION COMMISSION
OCT 21 1965
10-21-65
CONSERVATION DIVISION
Wichita, Kansas

I certify that this is a true and correct copy of the above log to the best of my knowledge.

Paul W. Hesse
Paul W. Hesse

Subscribed and sworn to before me this 12th day of March, 1956

Duane Jessup
Duane Jessup - Notary Public

My commission expires December 11, 1957