

15-887-0675-0000

STATE OF KANSAS  
STATE CORPORATION COMMISSION


Give All Information Completely  
Make Required Affidavit  
Mail or Deliver Report to:  
Conservation Division  
State Corporation Commission  
800 Bitting Building  
Wichita, Kansas

WELL PLUGGING RECORD

Barber County, Sec. 6 Twp. 34S Rge. (E) 12 (W)

Location as "NE/CNWxSWx" or footage from lines SW SW NE  
Lease Owner O'Connor-Grant-Billingsley  
Lease Name McCracken Well No. 1  
Office Address 710 Petroleum Building - Wichita, Kansas  
Character of Well (completed as Oil, Gas or Dry Hole) Dry Hole  
Date well completed March 8 1956  
Application for plugging filed March 8 1956  
Application for plugging approved March 8 1956  
Plugging commenced March 8 1956  
Plugging completed April March 8 1956  
Reason for abandonment of well or producing formation AB wa

NORTH

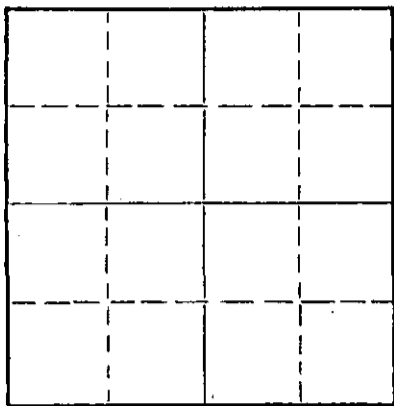

Locate well correctly on above  
Section Plat

If a producing well is abandoned, date of last production \_\_\_\_\_ 19\_\_\_\_  
Was permission obtained from the Conservation Division or its agents before plugging was commenced? Yes

Name of Conservation Agent who supervised plugging of this well M. A. Rives  
Producing formation \_\_\_\_\_ Depth to top \_\_\_\_\_ Bottom \_\_\_\_\_ Total Depth of Well 4800 Feet  
Show depth and thickness of all water, oil and gas formations.

OIL, GAS OR WATER RECORDS

CASING RECORD

FORMATION	CONTENT	FROM	TO	SIZE	PUT IN	PULLED OUT
				8-5/8"	265'	

Describe in detail the manner in which the well was plugged, indicating where the mud fluid was placed and the method or methods used in introducing it into the hole. If cement or other plugs were used, state the character of same and depth placed, from \_\_\_\_\_ feet to \_\_\_\_\_ feet for each plug set.

Filled hole with heavy mud to 260'; set plug with 1/3 sacks of Hulls and 20 sacks of Cement.

Filled hole with heavy mud to 35'; set second plug with 1/3 sacks of Hulls and 10 sacks of cement.

APR 12 4-12-56  
CONS. DIV. STATE CORP. COM. WICHITA, KANSAS

(If additional description is necessary, use BACK of this sheet)  
Name of Plugging Contractor Strata Drilling, Inc.  
Address McBride Building - Great Bend, Kansas

STATE OF KANSAS COUNTY OF BARTON, ss.  
CHARLES W. STEINCAMP (contractor) of the above-described well, being first duly sworn on oath, says: That I have knowledge of the facts, statements, and matters herein contained and the log of the above-described well as filed and that the same are true and correct. So help me God.

(Signature) Charles W. Steincamp  
McBride Building - Great Bend, Kansas  
(Address)

SUBSCRIBED AND SWORN to before me this 11th day of April, 19 56

My commission expires November 21, 1959  
Mary O. Johnson Notary Public.

PLUGGING  
FILE SEC 6 T 34 R 12W  
BOOK PAGE 53 LINE 9

DRILLERS LOG

Company: O'Connor-Grant-Billingsley      Location: SW SW NE  
 Contractor: Strata Drilling, Inc.      Barber County, Kansas  
    Section 6-23S-12W  
 Farm Name: McCracken #1      Elevation: 1529' KB  
 Cominenced: March 23, 1956      Casing: 8-5/8" 24# (265') new casing  
 Completed: April 8, 1956

0-	35	Top Soil and Sand
	580	Red Bed
	1395	Shale and Shell
	1775	Anhydrite
	2045	Shale and Lime
	3125	Lime
	3880	Shale and Lime
	3960	Shale and Cherty Lime
	4100	Shale and Lime
	4360	Lime
	4400	Lime and Cherty Lime
	4490	Lime
	4545	Lime and Shale
	4640	Lime
	4693	Lime and Shale
	4795	Lime
	Total Depth	4795' KB

STATE OF KANSAS )  
 )      SS.  
 COUNTY OF BARTON)

I, the undersigned, being duly sworn on oath, state that the above statement and log are true and a correct record and log of the well drilled at the location above described.

STRATA DRILLING, INC.

*Charles W. Steincamp*  
 CHARLES W. STEINCAMP      President

Subscribed and sworn before me this 11th day of April, 1956

*Mary O. Johnson*  
 Mary O. Johnson      Notary Public

My Commission Expires November 21, 1959

4-12-56

**PLUGGING**  
 FILE SEC 6 T 34 R 12W  
 BOOK PAGE 53 LINE 9