


15-007-01676-0000

STATE OF KANSAS
STATE CORPORATION COMMISSION

Give All Information Completely
Make Required Affidavit
Mail or Deliver Report to:
Conservation Division
State Corporation Commission
211 No. Broadway
Wichita, Kansas

WELL PLUGGING RECORD

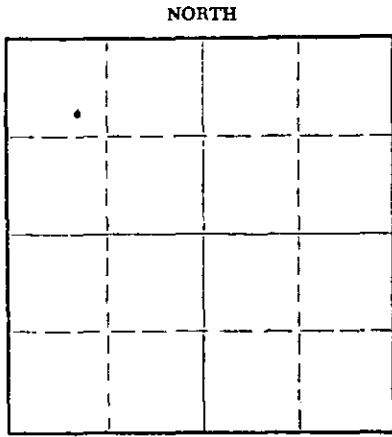

Locate well correctly on above
Section Plat

Barber County. Sec. 7 Twp. 34 Rge. (E) 12 (W)
Location as "NE/CNW/SW" or footage from lines C SE NW NW
Lease Owner The Atlantic Refining Company
Lease Name Minnie Donovan Well No. 1
Office Address 830 Kennedy Building, Tulsa, Oklahoma
Character of Well (completed as Oil, Gas or Dry Hole) Dry Hole
Date well completed 4-27 19 56
Application for plugging filed 4-27 19 56
Application for plugging approved 4-27 19 56
Plugging commenced 4-27 19 56
Plugging completed 4-28 19 56
Reason for abandonment of well or producing formation _____

If a producing well is abandoned, date of last production _____ 19 _____
Was permission obtained from the Conservation Division or its agents before plugging was commenced? Yes

Name of Conservation Agent who supervised plugging of this well M. A. Rives, Box 8, Pratt, Kansas
Producing formation _____ Depth to top _____ Bottom _____ Total Depth of Well 4854 Feet
Show depth and thickness of all water, oil and gas formations.

OIL, GAS OR WATER RECORDS

CASING RECORD

FORMATION	CONTENT	FROM	TO	SIZE	PUT IN	PULLED OUT
<u>Lansing</u>	<u>Water</u>	<u>4150</u>	<u>4184</u>	<u>8-5/8"</u>	<u>240.39'</u>	<u>None</u>
<u>Cherokee</u>	<u>"</u>	<u>4730</u>	<u>4768</u>			
<u>Mississippian</u>	<u>"</u>	<u>4768</u>	<u>TD</u>			

Describe in detail the manner in which the well was plugged, indicating where the mud fluid was placed and the method or methods used in introducing it into the hole. If cement or other plugs were used, state the character of same and depth placed, from _____ feet to _____ feet for each plug set.

Ran drill pipe to bottom open-ended, spotted 100 sacks common Portland cement.
Pushed 8-5/8" HOWCO plug to 240 feet, and tied off with HOWCO wireline. Spotted
80 sacks common Portland cement in surface pipe. Job complete 8:00 a.m., 4-28-56.

(If additional description is necessary, use BACK of this sheet)

Name of Plugging Contractor Corbett Drilling Company
Address P. O. Box 4206, Tulsa, Oklahoma

STATE OF OKLAHOMA, COUNTY OF TULSA, ss.
Employee of owner (employee of owner) or (owner or operator) of the above-described well, being first duly sworn on oath, says: That I have knowledge of the facts, statements, and matters herein contained and the log of the above-described well as filed and that the same are true and correct. So help me God.

(Signature) J. E. Hellinghausen
J. E. Hellinghausen, Regional Drilling Manager
830 Kennedy Building, Tulsa, Oklahoma
(Address)

SUBSCRIBED AND SWORN TO before me this 30th day of April, 19 56

My commission expires 4-6-59

Wanda Davis
Notary Public.
RECEIVED
STATE CORPORATION COMMISSION
MAY 21 1956
5-2-56
CONSERVATION DIVISION
Wichita, Kansas

PLUGGING
FILE SEC 7 T 34 R 12W
BOOK PAGE 57 LINE 38

THE ATLANTIC REFINING COMPANY
830 KENNEDY BUILDING
TULSA 3, OKLAHOMA

WELL LOG - MINNIE DONOVAN NO. 1

Location: Center SE NW NW of Section 7-34-12W, Barber County, Kansas.

Lease No. KS-15,426

Elevations: RKB 1590'; GL 1580'; DF 1587'.

Spudded: 6:30 p.m., 4-6-56. Reached Total Depth: 4-24-56.

Contractor: Corbett Drilling Company, P. O. Box 4206, Tulsa, Oklahoma.

Casing Record: Set 8-5/8" OD 22.7# Spiral Weld casing at 253.14' with 250 sacks common cement with 1% calcium chloride added.

FORMATION RECORD

0 - 1265	Red bed & shale
1265 - 1425	Shale & shells
1425 - 1920	Shale & lime
1920 - 2490	Lime
2490 - 2890	Shale & lime
2890 - 2940	Sandy lime & sand
2940 - 3580	Lime & shale
3580 - 3695	Sand
3695 - 3840	Sand, Sandy lime & shale
3840 - 4025	Sandy lime & shale
4025 - 4375	Lime
4375 - 4515	Sandy lime & shale
4515 - 4790	Lime
4790 - 4854	Chert
4854 Total Depth	

COMPLETION

- DST #1 4732-65': Tool open 1 hr., recovered 250' rathole mud, trace SW. IFF 100#. FFP 140#. BHSIP 1860# in 25 min.
- DST #2 4765-90': Tool open 1 hr., recovered 120' salt water cut mud & 155' SW. IFF 130#. FFP 160#. BHSIP 1810# in 30 min.
- DST #3 4816-54': Tool open 1 hr., recovered 45' rathole mud, no show. I&FFP 42#. BHSIP 62# in 30 min.
- DST #4 4150-84': Tool open 1 hr. 27 min., recovered 90' mud cut salt water & 2860' SW. IFF 410#. FFP 1530#. BHSIP 1620# in 30 min.

DRY HOLE. PLUGGED & ABANDONED 4-27-56.

STATE OF OKLAHOMA)
) SS:
COUNTY OF TULSA)

I, the undersigned, being first duly sworn upon oath, state that this well record is true, correct, and complete according to the records of this office and to the best of my knowledge and belief.

J. E. Hellinghausen
J. E. Hellinghausen
Regional Drilling Manager

Subscribed and sworn to before me this 30th day of April, 1956.

My commission expires 4-6-59

PLUGGING
FILE SEC 7 T 34 R 12W
BOOK PAGE 57 LINE 38

Wanda Davis
5-2-56
Wanda Davis, Notary Public
Wichita, Kansas