

15-111-20167-0000

STATE OF KANSAS
STATE CORPORATION COMMISSION

Form 614

Give All Information Completely
Make Required Affidavit
Mail or Deliver Report to
Conservation Division
State Corporation Commission

WELL PLUGGING RECORD

P. O. Box 17027
Wichita, Kansas 67217
NORTH

Lyon County, Sec. 9 Twp. 16 Rgs. 10 (E) (W)

Location as "NE/CNW/SE/SW" or footage from lines SW NE SW

Lease Owner Mack Oil Company

Lease Name Trust Well No. 3

Office Address Box 400, Duncan, Oklahoma 73533

Character of Well (completed as Oil, Gas or Dry Hole) Dry Hole

Date well completed 8/14/75 19

Application for plugging filed 8/14/75 19

Application for plugging approved 8/14/75 19


Plugging commenced 8/14/75 19

Plugging completed 8/14/75 19

Reason for abandonment of well or producing formation Dry Hole

If a producing well is abandoned, date of last production 19

Was permission obtained from the Conservation Division or its agents before plugging was commenced? yes

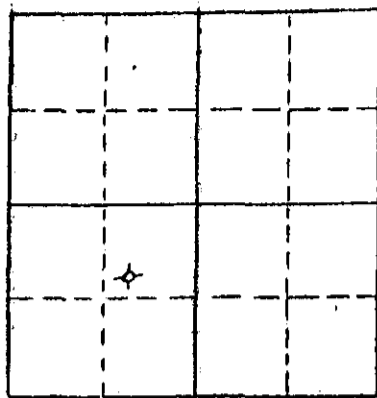

Locate well correctly on above
Section Plat

Name of Conservation Agent who supervised plugging of this well Merle Hickey

Producing formation Depth to top Bottom Total Depth of Well 3100 Feet

Show depth and thickness of all water, oil and gas formations.

OIL, GAS OR WATER RECORDS

CASING RECORD

FORMATION	CONTENT	FROM	TO	SIZE	PUT IN	PULLED OUT
				7	204.43	0

Describe in detail the manner in which the well was plugged, indicating where the mud fluid was placed and the method or methods used in introducing it into the hole. If cement or other plugs were used, state the character of same and depth placed, from feet to feet for each plug set.

Drilling mud to 200', hull plug and 12 sacks cement at 200', mud to 50', hull plug and 8 sacks cement at 50', soil to surface.

RECEIVED
STATE CORPORATION COMMISSION

SEP 08 1975

CONSERVATION DIVISION
Wichita, Kansas

Name of Plugging Contractor, (If additional description is necessary, use BACK of this sheet) BMG, Inc.

Address Box 846, Independence, Kansas 67301

STATE OF Kansas COUNTY OF Montgomery ss. Wm. T. Philo

(employee of owner) or (owner) of the above-described well, being first duly sworn on oath, says: That I have knowledge of the facts, statements, and matters herein contained and the log of the above-described well as filed and that the same are true and correct. So help me God.

(Signature) [Signature] Box 846, Independence, Kansas 67301

Subscribed and sworn to before me this 26 day of August 1975

My commission expires 9/24/78 JANE McNICKLE Notary Public

Montgomery County, Kansas

15-111-20167-0000

soil	0	2
clay	2	14
shale	14	22
lime	22	25
shale	25	36
lime	36	40
shale	40	51
lime	51	57
shale	57	67
lime	67	70
shale	70	84
lime	84	99
shale	99	105
lime	105	121
shale	121	128
lime	128	131
shale	131	151
lime	151	157
shale w/lime streaks	157	202
lime	202	211
shale	211	217
lime	217	230
shale w/lime streaks	230	478
lime	478	482
shale	482	514
lime	514	520
shale	520	544
lime	544	547
shale	547	559
lime	559	563
shale	563	585
lime	585	596
shale	596	615
lime	615	617
shale w/lime streaks	617	687
lime	687	693
shale	693	766
lime w/ shale	766	786
shale	786	879
lime w/shale streaks	879	874
shale	874	896
lime w/shale streaks	896	933
lime/shale	933	960
lime	960	969
shale	969	994
lime/w/shale streaks	994	1050
shale w/lime streaks	1050	1258
lime	1258	1343
shale	1343	1438
lime	1438	1459
shale	1459	1467
lime	1467	1474
shale	1474	1481
lime	1481	1490
shale	1490	1497

RECEIVED
STATE CORPORATION COMMISSION

SEP 08 1975

CONSERVATION DIVISION
Wichita, Kansas

lime	1497	1528
shale	1528	1583
lime	1583	1618
shale	1618	1630
lime	1630	1641
shale/sand	1641	1666
lime w/shale streaks	1666	1814
shale	1814	1859
shale/sand	1859	1909
lime/shale	1909	1985
shale	1985	2002
lime	2002	2024
shale w/lime streaks	2024	2051
lime	2051	2059
shale w/lime streaks	2059	2456
Miss. lime	2456	2824
Kinderhook	2824	2968
Hunton	2968	2980
shale & lime	2980	3081
Viola	3081	3100


KANSAS DRILLERS LOG

S. 9 T. 16 R. 10 E
W

Loc. SW NE SW

County Lyon

640 Acres
N

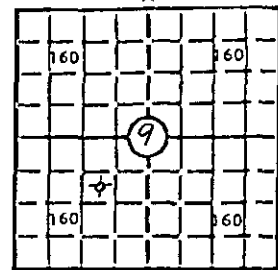

Elev.: Gr. _____

DF _____ KB _____

API No. 15 — 111 — 20167-00-00
County Number

Operator
Mack Oil Company

Address
Box 400, Duncan, Oklahoma 73533

Well No. 3 Lease Name Trust

Footage Location
feet from (N) (S) line feet from (E) (W) line

Principal Contractor Geologist
B & N Drilling

Spud Date Total Depth P.B.T.D.
8/6/75 3100

Date Completed Oil Purchaser
8/14/75

CASING RECORD

Report of all strings set — surface, intermediate, production, etc.

Purpose of string	Size hole drilled	Size casing set (in O.D.)	Weight lbs/ft.	Setting depth	Type cement	Sacks	Type and percent additives
Surface	9	7		204.43	common	65	3% CC

LINER RECORD

PERFORATION RECORD

Top, ft.	Bottom, ft.	Sacks cement	Shots per ft.	Size & type	Depth interval

TUBING RECORD

Size	Setting depth	Packer set at

ACID, FRACTURE, SHOT, CEMENT, SQUEEZE RECORD

Amount and kind of material used	Depth interval treated

RECEIVED
STATE CORPORATION COMMISSION
SEP 08 1975
CONSERVATION DIVISION
Wichita, Kansas

INITIAL PRODUCTION

Date of first production		Producing method (flowing, pumping, gas lift, etc.)			
RATE OF PRODUCTION PER 24 HOURS	Oil bbls.	Gas MCF	Water bbls.	Gas-oil ratio CFPB	
Disposition of gas (vented, used on lease or sold)			Producing interval(s)		

INSTRUCTIONS: As provided in KCC Rule 82-2-125, within 90 days after completion of a well, one completed copy of this Drillers Log shall be transmitted to the State Geological Survey of Kansas, 4150 Monroe Street, Wichita, Kansas 67209. Copies of this form are available from the Conservation Division, State Corporation Commission, 3830 So. Meridian (P.O. Box 17027), Wichita, Kansas 66217. Phone AC 316-522-2206. If confidential custody is desired, please note Rule 82-2-125. Drillers Logs will be on an open file in the Oil and Gas Division, State Geological Survey of Kansas, Lawrence, Kansas 66044.