


WELL PLUGGING RECORD

Give All Information Completely
Make Required Affidavit
Mail or Deliver Report to:
Conservation Division
State Corporation Commission
800 Bitting Building
Wichita, Kansas

Barber County, Sec. 8 Twp. 35 Rge. (E) 11 (W)

Location as "NE/CNW/SW" or footage from lines NW NW SW
Lease Owner Messman-Rinehart Oil Company
Lease Name Illinois Wesleyan University Well No. 1
Office Address Petroleum Building, Wichita, Kansas
Character of Well (completed as Oil, Gas or Dry Hole) Dry Hole
Date well completed June 11, 1956 19
Application for plugging filed June 11, 1956 (verbal) 19
Application for plugging approved June 11, 1956 (verbal) 19
Plugging commenced June 12, 1956 19
Plugging completed June 12, 1956 19
Reason for abandonment of well or producing formation Dry hole

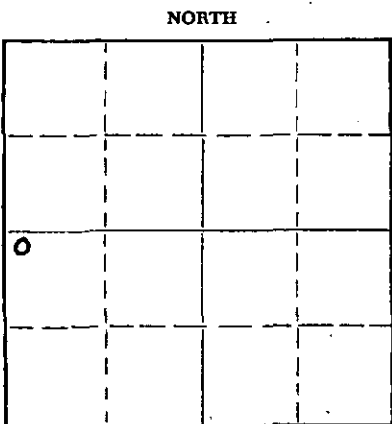

Locate well correctly on above Section Plat

If a producing well is abandoned, date of last production 19
Was permission obtained from the Conservation Division or its agents before plugging was commenced? Yes

Name of Conservation Agent who supervised plugging of this well M. A. Rives, Pratt, Kansas
Producing formation Depth to top Bottom Total Depth of Well 4840 Feet
Show depth and thickness of all water, oil and gas formations.

OIL, GAS OR WATER RECORDS

CASING RECORD

FORMATION	CONTENT	FROM	TO	SIZE	PUT IN	PULLED OUT
				8 5/8"	238	None

Describe in detail the manner in which the well was plugged, indicating where the mud fluid was placed and the method or methods used in introducing it into the hole. If cement or other plugs were used, state the character of same and depth placed, from feet to feet for each plug set.

Filled hole with heavy rotary mud to 235 feet. Set plug at 235 feet, 1/2 sack hulls and 20 sacks cement. Filled with mud to 35 feet. Set plug at 35 feet, 1/2 sack hulls and 10 sacks cement.

(If additional description is necessary, use BACK of this sheet)
Name of Plugging Contractor Graham-Michaelis Drilling Company
Address 1005 East Second, Wichita, Kansas

STATE OF Kansas, COUNTY OF Sedgwick, ss.
J. A. Gilliland (employee of owner) or (owner or operator) of the above-described well, being first duly sworn on oath, says: That I have knowledge of the facts, statements, and matters herein contained and the log of the above-described well as filed and that the same are true and correct. So help me God.

(Signature) J. A. Gilliland
Petroleum Building, Wichita, Kansas (Address)

SUBSCRIBED AND SWORN TO before me this 18th day of June, 1956

My commission expires November 5, 1958

RECEIVED Notary Public.
STATE CORPORATION COMMISSION

JUN 20 1956
6-20-56
CONSERVATION DIVISION
Wichita, Kansas

PLUGGING
FILE SEC. 8 T. 35 R. 11W
BOOK PAGE 71 LINE 26

ILLINOIS WESLEYAN UNIVERSITY #1Well Record

Location: NW/4 NW/4 SW/4 Sec. 8-358-11W
Barber County, Kansas
Commenced: May 28, 1956
Completed: June 12, 1956
(rotary)

Operator: Messman-Rinehart Drilling Company
Petroleum Building
Wichita, Kansas

Contractor: Graham-Michaelis Drilling Company
1008 East Second Street
Wichita 1, Kansas

Casing Record: 8-5/8" @ 238' w/175 sacks cement

LOG

Sand	238
Red Bed	270
Red Bed & Shale	1070
Red Bed, Shale & Anhydrite	1780
Lime & Shale	2308
Shale, Lime & Anhydrite	2416
Shale & Lime	3802
Shale	4179
Lime & Shale	4437
Lime	4472
Lime & Shale	4880
Lime	4762
Lime, Shale & Chirt.	4840, R.T.D.

STATE OF KANSAS)
) ss.
COUNTY OF SEDGWICK)

The undersigned, GRAHAM-MICHAELIS DRILLING COMPANY, hereby certifies that the above log is a true and correct log of the formations encountered in drilling the above well as reflected by the Daily Drilling Report.

GRAHAM-MICHAELIS DRILLING COMPANY

By John L. James
John L. James
Geologist.

Subscribed and sworn to before me
this 18th day of June, 1956.

Mary E. Barnes

My commission expires: 11/7/57.

RECEIVED
STATE COMMISSION

PLUGGING
FILE SEC. 8 T. 35 R. 11W
BOOK PAGE 71 LINE 26

6-20-56