


STATE OF KANSAS
STATE CORPORATION COMMISSION

WELL PLUGGING RECORD

Give All Information Completely
Make Required Affidavit
Mail or Deliver Report to
Conservation Division
State Corporation Comm.
245 North Water
Wichita, KS 67202

BARBER County, Sec. 6 Twp. 35S Rge. 11 E/W
Location as "NE/CNW $\frac{1}{4}$ SW $\frac{1}{4}$ " or footage from lines
C N $\frac{1}{2}$ SE - SW
Lease Owner Molz Oil Company
Lease Name Rathgeber Well No. B-1
Office Address Kiowa, Kansas 67070
Character of Well (Completed as Oil, Gas or Dry Hole)
Oil

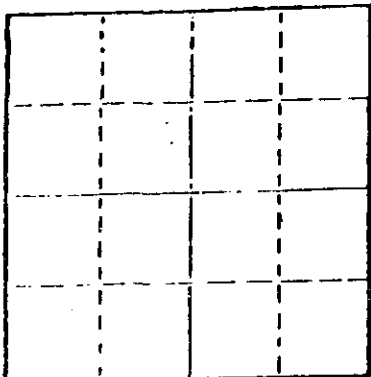

Locate well correctly on above
Section Plot

Date Well completed 5-21 19 26
Application for plugging filed 5-25 19 79
Application for plugging approved 5-27 19 79
Plugging commenced 6-11 19 79
Plugging completed 6-15 19 79
Reason for abandonment of well or producing formation

If a producing well is abandoned, date of last production 19

Was permission obtained from the Conservation Division or
its agents before plugging was commenced? YES

Name of Conservation Agent who supervised plugging of this well BILL OWENS
Producing formation Depth to top Bottom Total Depth of Well 5177
Show depth and thickness of all water, oil and gas formations.

OIL, GAS OR WATER RECORDS

CASING RECORD

FORMATION	CONTENT	FROM	TO	SIZE	PUT IN	PULLED OUT
				10 3/4	325	NONE
				4 1/2	5176	4117.11

Describe in detail the manner in which the well was plugged, indicating where the mud fluid
was placed and the method or methods used in introducing it into the hold. If cement or other
plugs were used, state the character of same and depth placed, from feet to
feet for each plug set.

ALLIED, PUMPED IN 60 SACKS CEMENT. PLUGGED OFF. PERFORATED. RIPPED PIPE
AT AND PULLED 4 1/2" CASING. ALLIED PUMPED IN 5 SACKS HILL. 25 SACKS JEL.
190 SACKS 50-50 POX 2% JEL.

RECEIVED
STATE CORPORATION COMMISSION

DEC 20 1979
12-20-79
CONSERVATION DIVISION
Wichita, Kansas

(If additional description is necessary, use BACK sheet)

Name of Plugging Contractor CLARKE CORPORATION

STATE OF COUNTY OF, ss.
(employee of owner) or (owner or operator)

of the above-described well, being first duly sworn on oath, says: That I have knowledge of
the facts, statements, and matters herein contained and the log of the above-described well
as filed and that the same are true and correct. So help me God.

(Signature) *Edward J. [Signature]*
(Address)

SUBSCRIBED AND SWORN TO before me this day of, 19

Notary Public.

My commission expires