


WELL PLUGGING RECORD

Give All Information Completely
Make Required Affidavit

COUNTY Barton SEC. 25 TWP. 33S RGE. 14 W
Location as in quarters or footage from lines:

NW - NW - SE

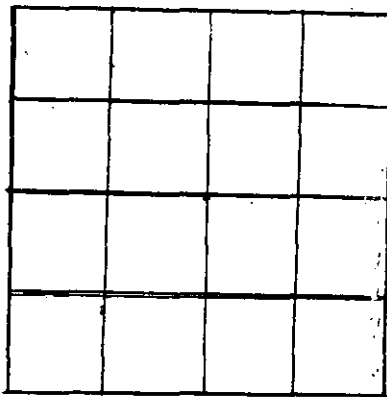

Locate Well
correctly on above
Section Platt.

Lease Owner Reach Group
Lease Name BOWMAN # Well No. 1
Office Address Box 447 Great Bend Kan
Character of Well (Completed as Oil, Gas or Dry Hole): Oil and Gas
Date Well Completed 12-10-1980
Application for plugging filed 3-21-83
Plugging commenced March 9, 1983
Plugging completed March 10, 1983
Reason for abandonment of well or producing formation _____

dry
Was permission obtained from the Conservation Division or it's Agent's before plugging was commenced? yes

Name of Conservation Agent who supervised plugging of this well Bud Metz
Producing formation _____ Depth to top 4780-86 bottom 4796 - T.D. 4880
Show depth and thickness of all water, oil and gas formations. 4804

OIL, GAS OR WATER RECORDS

Casing Record

Formation	Content	From	To	Size	Put in	Pulled Out
		0	310	8 5/8	310	0
		0	4880	4 1/2	4480	2300'

Describe in detail the manner in which the well was plugged, indicating where the mud fluid was placed and the method or methods used in introducing it into the hold. If cement or other plugs were used, state the character of same and depth placed, from _____ feet to _____ feet for each plug set.


squeezed bottom with 25 sk cement
Plugged top with 2 sk shells cement 60/40 pro
15 sk gel 27 gel
50 sk cement 3 3/8 C.C
10 sk gel
1 sk shell shut in pressure
8 5/8 plug 300'
100 sk cement

(If additional description is necessary, use BACK of this sheet)

Name of Plugging Contractor _____

STATE OF KANSAS COUNTY OF BARTON, ss.

Keith W. Barlow (employee of owner) or (owner or operator) of the above-described well, being first duly sworn on oath, says: That I have knowledge of the facts, statements, and matters herein contained and the log of the above-described well as filed and that the same are true and correct. So help me God.

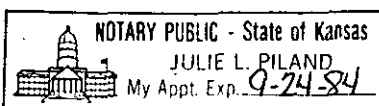

(Signature) Keith W. Barlow
Great Bend Kan
(Address)

SUBSCRIBED AND SWORN TO before me this 19th day of May, 19 83

RECEIVED
STATE CORPORATION COMMISSION Julie L. Piland
Notary Public.

My Commission expires: 9-24-84

MAY 20 1983
5-20-83
CONSERVATION DIVISION
Wichita, Kansas