


15-007-01667-0000

STATE OF KANSAS
STATE CORPORATION COMMISSION

WELL PLUGGING RECORD

Give All Information Completely
Make Required Affidavit
Mail or Deliver Report to:
Conservation Division
State Corporation Commission
800 Bitting Building
Wichita, Kansas

Barber County, Sec. 25 Twp. 33 Rge. (E) 14 (W)
Location as "NE/CNW&SWK" or footage from lines App Ctr NE/4
Lease Owner Gramehart-Miller Oil Company
Lease Name Lenkner "C" Well No. 1
Office Address 1005 East Second, Wichita, Kansas
Character of Well (completed as Oil, Gas or Dry Hole) Dry Hole
Date well completed June 3, 1955 19
Application for plugging filed June 3, 1955 19
Application for plugging approved June 6, 1955 19
Plugging commenced June 16, 1955 19
Plugging completed June 19, 1955 19
Reason for abandonment of well or producing formation Dry Hole

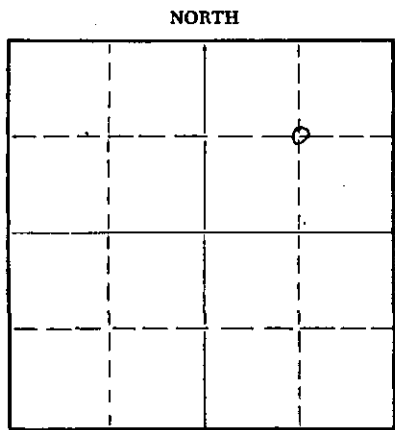

NORTH
Locate well correctly on above
Section Plat

If a producing well is abandoned, date of last production 19
Was permission obtained from the Conservation Division or its agents before plugging was commenced? Yes

Name of Conservation Agent who supervised plugging of this well M. A. Rives, Box 8, Pratt, Kansas
Producing formation _____ Depth to top _____ Bottom _____ Total Depth of Well 4853 Feet
Show depth and thickness of all water, oil and gas formations.

OIL, GAS OR WATER RECORDS

CASING RECORD

FORMATION	CONTENT	FROM	TO	SIZE	PUT IN	PULLED OUT
				8 5/8	264	None
				5 1/2	4852	4733

Describe in detail the manner in which the well was plugged, indicating where the mud fluid was placed and the method or methods used in introducing it into the hole. If cement or other plugs were used, state the character of same and depth placed, from _____ feet to _____ feet for each plug set.

Plugged back with crushed rock to 4745', dumped 5 sacks cement at 4745' with dump bailer. Top of cement 4710'. Filled with mud to 264', set rock bridge, dumped 20 sacks cement. Top of cement 200'. Filled with mud to 35'. Set rock bridge, dumped 10 sacks cement for cap.

RECORDED
STATE CORPORATION COMMISSION

JUL 13 1955

7-13-55
CONSERVATION DIVISION

(If additional description is necessary, use BACK of this sheet)
Name of Plugging Contractor J&M Casing Pulling Company (License No. 11) Wichita, Kansas
Address P. O. Box 711, Great Bend, Kansas

STATE OF Kansas, COUNTY OF Sedgwick, ss.
J. A. Gilliland (employee of owner) and conservation operator of the above-described well, being first duly sworn on oath, says: That I have knowledge of the facts, statements, and matters herein contained and the log of the above-described well as filed and that the same are true and correct. So help me God.

(Signature) J. A. Gilliland
1005 East Second, Wichita, Kansas
(Address)

SUBSCRIBED AND SWORN TO before me this 11th day of July, 1955

My commission expires November 5, 1958

Juanita L. Louis
Notary Public.

PLUGGING
FILE SEC 25 T 33 R 14W
BOOK PAGE 124 LINE 24

NO. 1 LUSHNER "C"

WELL RECORD

Location: App Ctr 98/4, 25-339-11W
 Barber County, Kansas
 Operator: Cranchart-Miller Oil Company
 1005 East Second, Wichita, Kansas
 Contractor: Graham-Messner-Rinehart Drilling Co.
 1005 East Second, Wichita, Kansas
 Casing Record: 8 5/8" @ 264' w/170 sacks cement
 5 1/2" @ 4852' w/130 sacks cement

Commenced: April 16, 1955
 Completed: April 29, 1955
 Elevation: 2854' ND
 Production:

....L O O....

Red Bed-Sand	10
Clay-Red Bed	190
Clay-Red Bed	266
Red Bed-Shale-Shells	1291
Red Bed-Shale	1995
Shale-Lime	2210
Lime-Shale	2390
Shale-Lime	2730
Lime-Shale	2880
Shale-Lime	3105
Lime-Shale	3519
Shale-Lime	3819
Lime-Shale	3957
Shale-Lime	4105
Lime-Shale	4205
Lime-Shale	4405
Lime	4788
Miss.	4831
Lime	4859 R.T.D.

Sample Tops:

Locampton 3801 (-1950)
 Elgin Zone 3819 (-1995)
 Elgin Sand 3889 (-2035)
 Heebner 4031 (-2177)
 Douglas 4068 (-2211)
 Douglas sd 4078 (-2221)
 Lansing 4213 (-2359)
 Miss 4756 (-2900)

The undersigned, GRAHAM-MESSNER-RINEHART DRILLING COMPANY, hereby certifies that the above log is a true and correct log of the formation encountered in drilling the above well as reflected by the Daily Drilling Report.

GRAHAM-MESSNER-RINEHART DRILLING COMPANY

RECEIVED
 DIVISION OF COMMISSIONERS
 JUL 13 1955
 7-13-55
 CONSERVATION DIVISION
 WICHITA, KANSAS

By: J. K. Gilliland
 J. K. Gilliland

Subscribed and sworn to before me this 14th day of May, 1955.

Juanita L. Davis
 Notary Public

My Commission Expires: November 5, 1958

PLUGGING
 FILE SEC. 25T-33R-14W
 BOOK PAGE 42 LINE 24