


STATE OF KANSAS  
STATE CORPORATION COMMISSION

Give All Information Completely  
Make Required Affidavit  
Mail or Deliver Report to:  
Conservation Division  
State Corporation Commission  
800 Biting Building  
Wichita, Kansas

WELL PLUGGING RECORD

NORTH

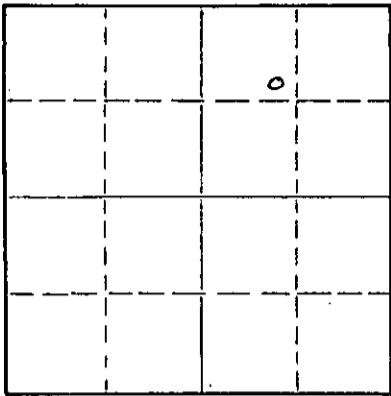

Locate well correctly on above  
Section Plat

Barber County, Sec. 25 Twp. 33S Rge. (E) 11 (W)  
Location as "NE/CNWxSWx" or footage from lines SE NW NE  
Lease Owner Gramehart-Miller Oil Company  
Lease Name Lenker "G" Well No. 2  
Office Address 1005 East Second, Wichita, Kansas  
Character of Well (completed as Oil, Gas or Dry Hole) Dry Hole  
Date well completed March 25, 1956 19  
Application for plugging filed March 26, 1956 19  
Application for plugging approved March 27, 1956 19  
Plugging commenced April 10, 1956 19  
Plugging completed April 14, 1956 19  
Reason for abandonment of well or producing formation Dry Hole

If a producing well is abandoned, date of last production 19  
Was permission obtained from the Conservation Division or its agents before plugging was commenced? Yes

Name of Conservation Agent who supervised plugging of this well Merle Rives, Pratt, Kansas  
Producing formation Depth to top Bottom Total Depth of Well 4799 Feet  
Show depth and thickness of all water, oil and gas formations.

OIL, GAS OR WATER RECORDS

CASING RECORD

FORMATION	CONTENT	FROM	TO	SIZE	PUT IN	PULLED OUT
				8 5/8"	266'	None
				5 1/2"	4763'	3704

Describe in detail the manner in which the well was plugged, indicating where the mud fluid was placed and the method or methods used in introducing it into the hole. If cement or other plugs were used, state the character of same and depth placed, from feet to feet for each plug set.

Plugged back with crushed rock from 4799 to 4750. Dumped 5 sacks cement at 4750 with dump bailer. Top of cement 4715. Pumped 30 sacks of Gel-Mud behind 5 1/2" casing at 1800' by Globe Cementing Company. Filled hole with mud to 250'. Set rock bridge, dumped 20 sacks cement. Top of cement 190'. Filled hole with mud to 35', set rock bridge and dumped 10 sacks cement for cap.

APR 24 1956  
9-24-56  
CONSERVATION DIVISION  
WICHITA, KANSAS

(If additional description is necessary, use BACK of this sheet)  
Name of Plugging Contractor Miller Casing Pulling Company (Licensd No. 12)  
Address Box 711, Great Bend, Kansas

STATE OF Kansas, COUNTY OF Sedgwick, ss.  
J. A. Gilliland (employee of owner) or (owner) of the above-described well, being first duly sworn on oath, says: That I have knowledge of the facts, statements, and matters herein contained and the log of the above-described well as filed and that the same are true and correct. So help me God.

(Signature) *J. A. Gilliland*  
1005 East Second, Wichita, Kansas (Address)

SUBSCRIBED AND SWORN TO before me this 19th day of April, 19 56

My commission expires November 5, 1958  
Juanita L. Davis Notary Public.

PLUGGING  
FILE SEC. 25 T. 33 R. 14 W.  
BOOK PAGE 48 LINE 31

NO. 2 LEADERS LOG

WELL LOG

Location: SE NW NE, 25-338-14W  
Barber County, Kansas

Operator: Graham-Miller Oil Company  
1005 East Second, Wichita, Kansas

Contractor: Graham-Messman-Rinehart Drilling Co.  
1005 East Second, Wichita, Kansas

Casing Records: 8 5/8" @ 266' w/175 sacks cement  
5 1/2" @ 4763' w/50 sacks cement

Commenced: March 7, 1956  
Completed: March 19, 1956  
Elevation: 1863 MD (1852 Gr)  
Production: DSA

.....L O G.....

Red Red-Sand	10
Clay-Red Bed	267
Red Shale-Shells	890
Shale-Shells	1000
Shale-Red Bed	1451
Shale-Lime	2004
Lime-Shale	3178
Shale-Lime	3448
Shale	3568
Lime-Shale	4227
Lime	4763 R.T.D.

Sample Tops:

Lansing 4221 (-2358)  
Mississippi 4757 (-2894)  
Miss. Lime 4789 (-2926)

Deepened with cable tools:

Chert-Shale	4769
Shaley Chert-Lime	4773
Chert-Dolomite	4778
Cherty Dol-Siltstone	4785
Green Shale	4789
Cherty Lime	4799 T.D. (Log T.D. 4801)

The undersigned, GRAHAM-MESSMAN-RINEHART DRILLING COMPANY, hereby certifies that the above log is a true and correct log of the formation encountered in drilling the above well as reflected by the Daily Drilling Report.

GRAHAM-MESSMAN-RINEHART DRILLING COMPANY

By: J. A. Gilliland  
J. A. Gilliland

Subscribed and sworn to before me this 20th day of March, 1956.

Luanna L. Lewis  
Notary Public

My Commission Expires: November 5, 1958

**PLUGGING**  
FILE SEC 25 T 33 R 14W  
BOOK PAGE 48 LINE 31

RECEIVED  
STATE CORPORATION COMMISSION

APR 24 1956  
4-24-56  
CONSERVATION DIVISION  
Wichita, Kansas