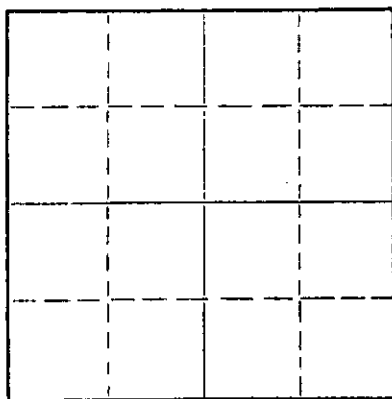


Give All Information Completely
Make Required Affidavit
Mail or Deliver Report to:
Conservation Division
State Corporation Commission
211 No. Broadway
Wichita, Kansas

WELL PLUGGING RECORD

NORTH



Locate well correctly on above
Section Plat

Barber County, Sec. 16 Twp. 33S Rge. 14W (E) (W)
Location as "NE/CNW/SW" or footage from lines C SE NW
Lease Owner Jones-Gebert Oil Co.
Lease Name McGRATH Well No. #1
Office Address
Character of Well (completed as Oil, Gas or Dry Hole) Dry Hole
Date well completed May 1 19 63
Application for plugging filed May 1 19 63
Application for plugging approved May 1 19 63
Plugging commenced May 1 19 63
Plugging completed May 1 19 63
Reason for abandonment of well or producing formation Dry Hole

If a producing well is abandoned, date of last production 19
Was permission obtained from the Conservation Division or its agents before plugging was commenced? Yes

Name of Conservation Agent who supervised plugging of this well Archie V. Elving
Producing formation Depth to top Bottom Total Depth of Well 4751 Feet
Show depth and thickness of all water, oil and gas formations.

OIL, GAS OR WATER RECORDS

CASING RECORD

FORMATION	CONTENT	FROM	TO	SIZE	PUT IN	PULLED OUT
				8 5/8"	812 ft.	

Describe in detail the manner in which the well was plugged, indicating where the mud fluid was placed and the method or methods used in introducing it into the hole. If cement or other plugs were used, state the character of same and depth placed, from feet to feet for each plug set.

Plugs set at 805' w/25 sx.
400' w/25 sx.
40' w/15 sx.

RECEIVED
STATE CORPORATION COMMISSION

MAY 15 1963
5-15-63

CONSERVATION DIVISION
WICHITA, KANSAS

(If additional description is necessary, use BACK of this sheet)

Name of Plugging Contractor Jones-Gebert Oil, Inc.
Address 205 Central Building, Wichita, Kansas

STATE OF KANSAS, COUNTY OF SEDGWICK, ss.
George R. Jones

(producer or owner) or (owner or operator) of the above-described well, being first duly sworn on oath, says: That I have knowledge of the facts, statements, and matters herein contained and the log of the above-described well as filed and that the same are true and correct. So help me God.

(Signature) George R. Jones
205 Central Building, Wichita, Kansas
(Address)

SUBSCRIBED AND SWORN to before me this 9th day of May, 1963

My commission expires February 1, 1964

Barbara J. Layton
Barbara J. Layton Notary Public.

DRILLERS' LOG

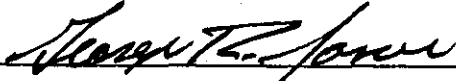
Company: Jones-Gebert Oil Co.
 Contractor: Jones-Gebert Oil, Inc.
 Farm: #1 McGrath, C SE NW
 Sec. 16-33S-14W
 Barber County, Kansas
 Commenced: 4/19/63
 Completed: 5/1/63
 Casing: 8 5/8" @ 812' w/400 sx.

0 - 220	Gypsum & Red Bed
220 - 650	Red Bed & Shale
650 - 700	Shale & Shells - Red Bed
700 - 775	Red Bed
775 - 812	Lime
812 - 1020	Red Bed & Shale
1020 - 1860	Shale & Shells
1860 - 2125	Lime & Shale
2125 - 2300	Lime
2300 - 2410	Lime
2410 - 2480	Lime
2480 - 2730	Shale & Lime
2730 - 2980	Shale & Lime
2980 - 3145	Lime & Shale
3145 - 3310	Shale & Lime
3310 - 3420	Shale & Lime
3420 - 3645	Shale & Lime
3645 - 3765	Shale & Lime
3765 - 3890	Shale & Lime
3890 - 3930	Lime & Shale
3930 - 4025	Sand & Lime
4025 - 4105	Shale & Lime
4105 - 4166	Lime & Shale
4166 - 4205	Lime
4205 - 4255	Lime
4255 - 4310	Lime
4310 - 4359	Lime
4359 - 4385	Lime
4385 - 4430	Lime
4430 - 4585	Lime
4585 - 4650	Lime & Shale
4650 - 4685	Lime
4685 - 4735	Lime & Shale
4735 - 4751	Lime
4751	T. D.

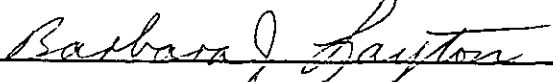
RECEIVED
 STATE CORPORATION COMMISSION

MAY 15 1963
 5-15-63
 CONSERVATION DIV.
 Wichita, Kansas

I, George R. Jones, do hereby certify that the above and foregoing is a true and correct copy of the log of the #1 McGrath, C SE NW, Sec. 16-33S-14W, Barber County, Kansas, as reflected by the files of Jones-Gebert Oil, Inc.


 George R. Jones

State of Kansas - County of Sedgwick) ss.
 Subscribed and sworn to before me, a Notary Public, in and for Sedgwick County, Kansas, this 8th day of May, 1963.


 Barbara J. Layton

My Commission Expires:
 February 1, 1964