

15-095-20908-0000


STATE OF KANSAS  
STATE CORPORATION COMMISSION

WELL PLUGGING RECORD

Give All Information Completely  
Make Required Affidavit  
Mail or Deliver Report to  
Conservation Division  
State Corporation Comm.  
245 North Water  
Wichita, KS 67202

Kingman County, Sec. 20 Twp. 29S Rge. 9W E/W  
Location as "NE/CNW $\frac{1}{4}$ SW $\frac{1}{4}$ " or footage from lines  
C SW NE

Lease Owner D. R. Lauck Oil Company, Inc.  
Lease Name Goetz Well No. 1  
Office Address 221 S. Broadway, Suite 400, Wichita, Ks.  
Character of Well (Completed as Oil, Gas or Dry Hole) Dry Hole

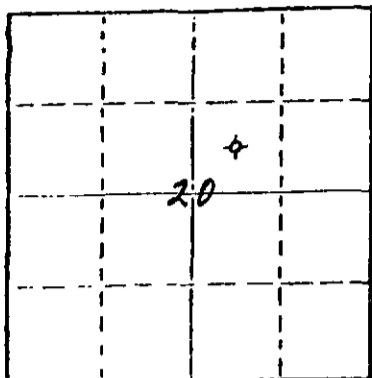

Locate well correctly on above  
Section Plat

Date Well completed December 18, 19 79  
Application for plugging filed December 18, 19 79  
Application for plugging approved December 18, 19 79  
Plugging commenced December 18, 19 79  
Plugging completed December 18, 19 79  
Reason for abandonment of well or producing formation Dry Hole

If a producing well is abandoned, date of last production 19

Was permission obtained from the Conservation Division or its agents before plugging was commenced? Yes

Name of Conservation Agent who supervised plugging of this well William T. Owen  
Producing formation \_\_\_\_\_ Depth to top \_\_\_\_\_ Bottom \_\_\_\_\_ Total Depth of Well \_\_\_\_\_  
Show depth and thickness of all water, oil and gas formations.

OIL, GAS OR WATER RECORDS

CASING RECORD

FORMATION	CONTENT	FROM	TO	SIZE	PUT IN	PULLED OUT
		0'	336'	8-5/8"	329.39'	None

Describe in detail the manner in which the well was plugged, indicating where the mud fluid was placed and the method or methods used in introducing it into the hold. If cement or other plugs were used, state the character of same and depth placed, from \_\_\_\_\_ feet to \_\_\_\_\_ feet for each plug set.

Plugged with 40 sacks cement at 330',  
plug and 1/2 sack hulls and 10 sacks  
cement at 40', and 5 sacks cement in  
rat hole.

(If additional description is necessary, use BACK of this sheet)

Name of Plugging Contractor Allied Cementing Co.

STATE OF KANSAS COUNTY OF SEDGWICK, ss.  
John D. Knightley (employee of owner) or (owner or operator)  
of the above-described well, being first duly sworn on oath, says: That I have knowledge of the facts, statements, and matters herein contained and the log of the above-described well as filed and that the same are true and correct. So help me God.

(Signature) [Signature]  
221 S. Broadway, Wichita, Kansas  
(Address)

SUBSCRIBED AND SWORN TO before me this 27th day of December, 19 79



[Signature]  
Notary Public.  
STATE CORPORATION COMMISSION

My commission expires March 12, 1983

DEC 28 1979

CONSERVATION DIVISION  
Wichita, Kansas

15-095-20908-0000

D. R. Lauck Oil Company, Inc. -  
221 S. Broadway, Suite 400  
Wichita, Kansas 67202

Goetz #1  
C SW NE Sec. 20-29S-9W  
Kingman County, Kansas

Contractor: D. R. Lauck Oil Company, Inc.  
221 S. Broadway, Suite 400  
Wichita, Kansas 67202

Commenced: December 8, 1979  
Completed: December 18, 1979

Drillers Log

Shale	340
Shale & Shells	1365
Shale	2315
Lime	3400
Shale & Lime	3748
Lime	4600 RTD

RECEIVED  
STATE CORPORATION COMMISSION

DEC 28 1979

CONSERVATION DIVISION  
Wichita, Kansas