


Give All Information Completely
Make Required Affidavit
Mail or Deliver Report to:
Conservation Division
State Corporation Commission
P. O. Box 17027
Wichita, Kansas 67217
NORTH

WELL PLUGGING RECORD

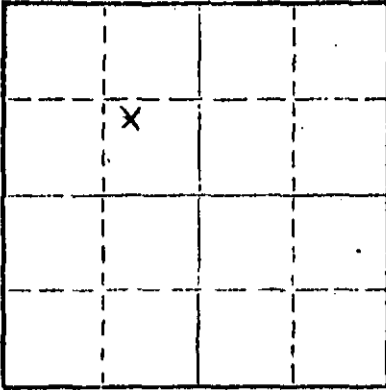

Locate well correctly on above
Section Plot

Barber County, Sec. 23 Twp. 33 Rge. 14 (E) W (W)
Location as "NE/CNWKSWK" or footage from lines NW SE NW
Lease Owner Mack Oil Company
Lease Name Baier Well No. #1
Office Address P. O. Box 400 ; Duncan, Okla.
Character of Well (completed as Oil, Gas or Dry Hole) _____
Date well completed _____ 19____
Application for plugging filed _____ November 19 73
Application for plugging approved _____ November 19 73
Plugging commenced _____ November 16 19 73
Plugging completed _____ December 24 19 73
Reason for abandonment of well or producing formation _____

If a producing well is abandoned, date of last production _____ 19____
Was permission obtained from the Conservation Division or its agents before plugging was commenced? Yes

Name of Conservation Agent who supervised plugging of this well Russell Biberstein
Producing formation _____ Depth to top _____ Bottom _____ Total Depth of Well _____ Feet
Show depth and thickness of all water, oil and gas formations.

OIL, GAS OR WATER RECORDS

CASING RECORD

FORMATION	CONTENT	FROM	TO	SIZE	PUT IN	PULLED OUT
				8 5/8"	314	None
				4 1/2"	4914	3600

Describe in detail the manner in which the well was plugged, indicating where the mud fluid was placed and the method or methods used in introducing it into the hole. If cement or other plugs were used, state the character of same and depth placed, from _____ feet to _____ feet for each plug set.

November 16, 1973 Plugged off bottom. Dumped sand to 4700'.
Mixed and dumped 4 sx of cement.
December 24, 1973 Plugged off top. Set 10' rock bridge at
320'. Filled 8 5/8" surface casing from
320' to base of cellar with 3000 lb. P.S.I.
ready-mix concrete.

RECEIVED
STATE CORPORATION COMMISSION
JAN 16 1974
CONSERVATION DIVISION
Wichita, Kansas

(If additional description is necessary, use BACK of this sheet)
Name of Plugging Contractor RUSS CASING PULLING, INC.
Address P. O. Box 1082 ; Great Bend, Kansas 67530

STATE OF OKLAHOMA, COUNTY OF STEPHENS, ss.
CARL A. BENTLEY (employee of owner) or (owner or operator) of the above-described well, being first duly sworn on oath, says: That I have knowledge of the facts, statements, and matters herein contained and the log of the above-described well as filed and that the same are true and correct. So help me God.

(Signature) Carl A. Bentley
P. O. Box 400, Duncan, Okla. 76833
(Address)

Subscribed and Sworn to before me this 14th day of January, 19 74
Josephine Bentley Notary Public.
My commission expires 3-24-75

DRILLING AND EXPLORATION COMPANY, INC.
Dallas, Texas

RECEIVED
STATE CORPORATION COMMISSION

JAN 17 1974
-17-74
CONSERVATION DIVISION
Wichita, Kansas

DRILLERS WELL LOG

Baier #1

Commenced R.D.: 10-17-59
Completed R.D.: 11-9-59
Total Depth: 4917'

NW SE NW Sec. 23-33S-14W
Barber County, Kansas
Elevation: 1894 K.B.
Initial Production:
Contractor: Mack Oil Co.

Casing Record: Set 8-5/8" at 314'
Set 4-1/2" at 4914'

STRATA	DEPTH
Sand	0 - 25'
Shale & Sand	25 - 140'
Shale	140 - 430'
Shale & Sand	430 - 808'
Shale & Shells	808 - 850'
Anhydrite	850 - 870'
Shale & Shells	870 - 1183'
Shale & Sand	1183 - 1635'
Shale & Shells	1635 - 2150'
Sand	2150 - 2215'
Lime	2215 - 2515'
Sand	2515 - 2630'
Lime	2630 - 2690'
Shale & Lime	2690 - 3075'
Lime	3075 - 3206'
Shale & Lime	3206 - 4092'
Shale & Sand	4092 - 4250'
Lime	4250 - 4333'
Lime & Shale	4333 - 4385'
Lime	4385 - 4917'

I hereby certify that the above is a true and correct log of said well as reflected by the daily drilling reports.

MACK OIL COMPANY

By Harold L. Steincamp

Signed and sworn to in my presence this 17th day of December, 1959,
by Harold L. Steincamp, a representative of Mack Oil Company.

Charles L. Sutton
Notary Public

My Commission Expires: May 6, 1961