

15007 - 10002 - 00-00

STATE OF KANSAS  
STATE CORPORATION COMMISSION

Form CP-4

Give All Information Completely  
Make Required Affidavit  
Mail or Deliver Report to:  
Conservation Division  
State Corporation Commission  
212 No. Market  
Wichita, Kansas

WELL PLUGGING RECORD

Barber County, Sec. 22 Twp. 33S Rge. 14(W)

Location as "NE/CNW/SW" or footage from lines NW SE NE

Lease Owner E. K. Edmiston

Lease Name HARBAUGH "D" Well No. 1

Office Address 405 First Natl Bank Bldg., Wichita, Kansas

Character of Well (completed as Oil, Gas or Dry Hole) gas

Date well completed August 12, 19 63

Application for plugging filed April 15, 19 74

Application for plugging approved April 17, 19 74


Plugging commenced May 9, 19 74

Plugging completed May 16, 19 74

Reason for abandonment of well or producing formation well below economic level

If a producing well is abandoned, date of last production April 17, 19 74

Was permission obtained from the Conservation Division or its agents before plugging was commenced? yes

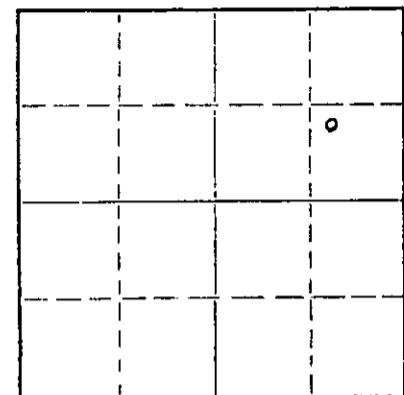

Locate well correctly on above Section Plat

Name of Conservation Agent who supervised plugging of this well Russell Biberstein

Producing formation \_\_\_\_\_ Depth to top \_\_\_\_\_ Bottom \_\_\_\_\_ Total Depth of Well 4775 Feet

Show depth and thickness of all water, oil and gas formations.

OIL, GAS OR WATER RECORDS

CASING RECORD

FORMATION	CONTENT	FROM	TO	SIZE	PUT IN	PULLED OUT
				10-3/4"	266'	None
				4 1/2"	4774	3285


Describe in detail the manner in which the well was plugged, indicating where the mud fluid was placed and the method or methods used in introducing it into the hole. If cement or other plugs were used, state the character of same and depth placed, from \_\_\_\_\_ feet to \_\_\_\_\_ feet for each plug set.

Sand from 4774 to 4700. Pumped 4 sacks cement from 4700 to 4665'.

Ripped at 4400, 4200, 4100, 4000, 3900, 3600 and 3500' (Rec. 3285' pipe)

Wood Bridge at 200'. Rock from 200 to 190'. 5 yds. of Ready Mix to top.

Bailer and 200 feet of sand lime cement in at 4665'.

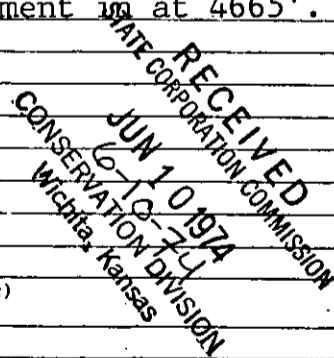

(If additional description is necessary, use BACK of this sheet)

Name of Plugging Contractor Clark Corp. (583)  
Address Box 187, Medicine Lodge, Kansas 67104

STATE OF Kansas COUNTY OF Barber ss.

Elmer R. Mergentern (employee of owner) or (owner or operator) of the above-described well, being first duly sworn on oath, says: That I have knowledge of the facts, statements, and matters herein contained and the log of the above-described well as filed and that the same are true and correct. So help me God.

(Signature) Elmer R. Mergentern  
Medicine Lodge, Kansas (Address)

SWORN TO before me this 6th day of June, 1974

Jessie Hamilton  
Notary Public.



DRILLER'S LOG

Company: E. K. Edmiston  
 501 First National Bank Building  
 Wichita 2, Kansas

Rotary Drilling Commenced: July 30, 1963

Rotary Drilling Completed: August 12, 1963

Well Name: HARBACH "D" No. 1  
 C NE SE NE Sec. 22-338-14W  
 Barber County, Kansas

Contractor: E. K. Edmiston Drilling Co., Inc.  
 501 First National Bank Building  
 Wichita 2, Kansas

Casing Record: 10-3/4" O 266' with 200 sacks cement  
 4-1/2" O 4775' with 100 sacks cement

L O G

Measurements from top of Rotary Bushing

Gyp and Red Bed	0 - 315
Shale Shells	880
Shale	1216
Shale and Lime	1950
Lime and Shale	2630
Shale and Lime	2990
Lime and Shale	3060
Shale and Lime	4040
Lime and Shale	4257
Lime	4775 RTD

RECEIVED  
 STATE CORPORATION COMMISSION  
 APR 16 1974  
 4-16-74  
 CONSERVATION DIVISION  
 Wichita, Kansas

The undersigned, E. K. Edmiston, President of E. K. Edmiston Drilling Co., Inc., hereby certifies on behalf of said company that the above log is a true and correct log of the formations encountered in drilling the above well as reflected by the daily drilling reports.

E. K. EDMISTON DRILLING CO., INC.

By: [Signature]  
E. K. Edmiston, President

STATE OF KANSAS,  
 SS:  

Be it remembered that on this 22nd day of August, 1963, before me, the undersigned, a notary Public, duly commissioned in and for said county and state aforesaid, came E. K. Edmiston, known to me to be the same person who executed the foregoing instrument as President and on behalf of E. K. Edmiston Drilling Co., Inc., and he duly acknowledged the execution of the same for himself and for said company.

In witness whereof, I have hereunto set my hand and official seal on the day and year last above written.

[Signature]  
A. B. Borgen, Notary Public

My commission expires  
 August 25, 1964