

RECEIVED
STATE CORPORATION COMMISSION


NOV 7 1974
11-7-74
CONSERVATION DIVISION
Wichita, Kansas

FORM CP-4

STATE OF KANSAS
STATE CORPORATION COMMISSION
CONSERVATION DIVISION
P. O. BOX 17037
WICHITA, KANSAS 67217

WELL PLUGGING RECORD

Barber County, Sec 22 Twp. 3.3.5 Rge. 14W (E) (W)
Location as "NE/CNW/SE" or footage from lines C. 20 1/2 - 0 1/2 S E 1/4
Lease Owner DON RIDER Prod.
Lease Name HAYBAUGH Well No. 1
Office Address 104.20 Lockwood Medicine Lodge, KANS
Character of Well (completed as Oil, Gas or Dry Hole) Gas
Date well completed _____ 19____
Application for plugging filed SEPT. 30 1974
Application for plugging approved " " 1974
Plugging commenced OCT 16 1974
Plugging completed OCT 23 1974
Reason for abandonment of well or producing formation Depleted
If a producing well is abandoned, date of last production _____ 19____
Was permission obtained from the Conservation Division or its agents before plugging was commenced? Yes

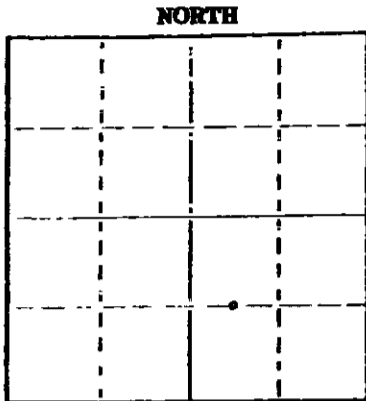

Locate well correctly on above Section Plot

Name of Conservation Agent who supervised plugging of this well Russell Biberstein
Producing formation M.S.S. Depth to top 4600 Bottom 4742 Total Depth of Well 4747 Feet
Show depth and thickness of all water, oil and gas formations.

OIL, GAS OR WATER RECORDS

CASING RECORD

FORMATION	CONTENT	FROM	TO	SIZE	PUT IN	PULLED OUT
	<u>13 3/8</u>	<u>0</u>	<u>225</u>	<u>13 3/8</u>		<u>NOH4</u>
	<u>8</u>	<u>0</u>	<u>1029</u>	<u>8 1/2</u>		<u>190'</u>
		<u>0</u>	<u>4678</u>	<u>5 1/2</u>		<u>4100'</u>

Describe in detail the manner in which the well was plugged, indicating where the mud fluid was placed and the method or methods used in introducing it into the hole. If cement or other plugs were used, state the character of same and depth placed, from _____ feet to _____ feet for each plug set.

BPT SAND & Plug @ 2600'
TOP- Plug @ 140' w/ 10' Rock Bridges & 3 yds Bedding cement to top.

(If additional description is necessary, use BACK of this sheet)
Name of Plugging Contractor Russ Cassin Drilling Inc.
Address PO Box 1082 - GREAT BEND KANSAS

STATE OF Nebraska COUNTY OF Barber, ss.

_____, (employee of owner) or (owner or operator) of the above-described well, being first duly sworn on oath, says: That I have knowledge of the facts, statements, and matters herein contained and the log of the above-described well as filed and that the same are true and correct. So help me God.

(Signature) Don C. Rider
104.20 Lockwood medicine Lodge, Kans
(Address)

Subscribed and sworn to before me this 6th day of November 1974

My commission expires 2-22-76
Imogene Fitzsimmons
Notary Public.

Sunray Mid-Continent Oil Company
Tulsa, Oklahoma

Tulsa, Oklahoma
October 31, 1957

CONTRACTOR: Stickle Drilling Company
Drilling Commenced: October 8, 1957
Drilling Completed: October 28, 1957

U.B. Harbaugh #1 SW/4
W/2 SE/4 Sec. 22-33S-
14W, Barber Co., Ks.

DRILLERS LOG

Depth Figures Indicate Base of Formation:

Shale & Shells	0
Shale & Shells	1890
Shale & Lime	1990
Lime	2555
Lime & Shale Streaks	2645
Lime & Shale	3965
Lime & Shale & Sand	4080
Lime & Shale	4155
Lime	4747

RECEIVED
STATE CORPORATION COMMISSION
SEP 30 1974
7-30-74
CONSERVATION DIVISION
Wichita, Kansas

I, Frank E. Stickle, hereby certify the above to be a true and complete Drillers Log of Sunray Mid-Continent Oil Company's U. B. Harbaugh #1 SW/4 W/2 SE/4 Section 22-33S-14W, Barber County, Kansas.

Frank E. Stickle
Frank E. Stickle

Lillian T. Bonham
Notary Public

February 13, 1960
My Commission Expires