


15-007-00476-0000

STATE OF KANSAS
STATE CORPORATION COMMISSION

Give All Information Completely
Make Required Affidavit
Mail or Deliver Report to:
Conservation Division
State Corporation Commission
800 Bitting Building
Wichita, Kansas

WELL PLUGGING RECORD

NORTH

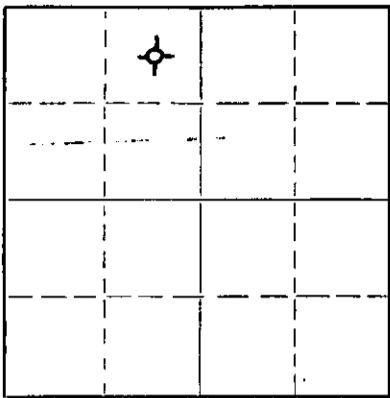

Locate well correctly on above
Section Plat

Barber County, Sec. 34 Twp. 33 S Rge. (E) 14 (W)
Location as "NE/CNW/SW" or footage from lines C of NE 1/4 - NW 1/4
Lease Owner Champlin Refining Company
Lease Name William A. Wheats Well No. 1
Office Address P.O. Dr. #552, Enid, Oklahoma
Character of Well (completed as Oil, Gas or Dry Hole) Dry Hole
Date well completed October 17, 19 52
Application for plugging filed October 17, 19 52
Application for plugging approved October 17, (Verbal) 19 52
Plugging commenced October 17, 19 52
Plugging completed October 17, 19 52
Reason for abandonment of well or producing formation

If a producing well is abandoned, date of last production 19
Was permission obtained from the Conservation Division or its agents before plugging was commenced? Yes

Name of Conservation Agent who supervised plugging of this well M. A. Rives, Pratt, Kansas
Producing formation Depth to top Bottom Total Depth of Well 5220 Feet
Show depth and thickness of all water, oil and gas formations.

OIL, GAS OR WATER RECORDS

CASING RECORD

FORMATION	CONTENT	FROM	TO	SIZE	PUT IN	PULLED OUT
				10 3/4" OD	404'	None

Describe in detail the manner in which the well was plugged, indicating where the mud fluid was placed and the method or methods used in introducing it into the hole. If cement or other plugs were used, state the character of same and depth placed, from feet to feet for each plug set.

Filled hole with heavy rotary mud from 5220' T. D. to 300' set a Halliburton at 300' and set cement plug using 20 sacks then filled hole with heavy rotary mud to 35' and set Halliburton plug and set cement plug in top using 10 sacks cement filling hole to bottom of celler.

10-22-52
Wichita, Kansas

(If additional description is necessary, use BACK of this sheet)

Name of Plugging Contractor Champlin Refining Company
Address Enid, Oklahoma

STATE OF Kansas, COUNTY OF Barton, ss.
S. P. Hall (employee of owner) or (Notary Public) of the above-described well, being first duly sworn on oath, says: That I have knowledge of the facts, statements, and matters herein contained and the log of the above-described well as filed and that the same are true and correct. So help me God.

(Signature) S. P. Hall
P.O. Box 167, Ellinwood, Kansas
(Address)


SUBSCRIBED AND SWORN TO before me this 21st day of October, 19 52

My commission expires Sept. 10, 1955

N. Kenneth Sturis
Notary Public.

PLUGGING
FILE SEC 34 T 33 R 14/2
BOOK PAGE 53 LINE 18

(For use in Kansas only for reporting formation record)

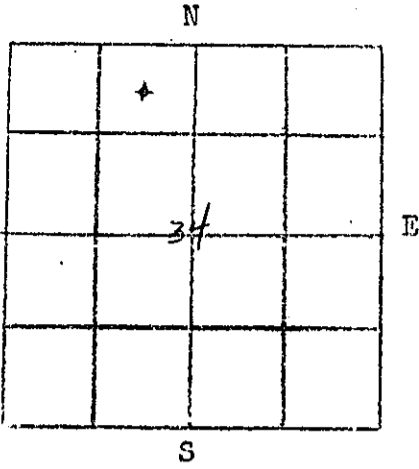

COUNTY Barber SEC. 34 TWP. 33S RGE. 14W
 COMPANY OPERATING Champlin Refining Company
 OFFICE ADDRESS Box 552 - Enid, Oklahoma
 FARM NAME William A. Wheats WELL NO. 1
 WELL LOCATED 1980' from the West Line & 660' from the North
Line of the NW/4, (center of NE/4 NW/4 34-33S-14W)
 CHARACTER OF WELL Dry Hole

DRILLING COMMENCED September 9, 1952 DRILLING COMPLETED October 17, 1952

SIZE	WEIGHT	THDS	MAKE	FT.	INS.	AMOUNT PULLED	CEMENT
10-3/4"	32.75#	8 Rd	National	408.36'			100 Sacks

FORMATION RECORD

Elevation: 1660' K.B.

	TOPS	BOTTOM		TOPS	BOTTOM
Shale	0	405	Lime-Shale	3960	4080
Redbed-Sand	405	1050	Lime	4080	4795
Shale-Shells	1050	1115	Shale-Lime	4795	4835
Shale-Redbed	1115	1420	Shale	4835	4855
Shale-Shells	1420	1625	Shale-Lime	4855	4875
Shale-Lime	1625	2030	Lime	4875	4895
Lime	2030	2405	Shale-Lime	4895	4978
Sandy Lime	2405	2505	Lime	4978	5010
Lime	2505	2565	Shale-Lime	5010	5040
Shale-Lime	2565	2690	Lime	5040	5105
Shale-Shells	2690	2780	Shale-Lime	5105	5135
Shale-Lime	2780	2855	Shale-Lime-Sand	5135	5151
Shale-Sand	2855	2955	Shale-Lime	5151	5200
Shale-Lime	2855	3005	Lime	5200	5220 T.D.
Shale-Lime-Shells	3005	3075			
Shale-Sand	3075	3155	<u>Geological Tops</u>		
Shale-Lime	3155	3270	Lecompton	3650	
Sand-Shells	3270	3310	Kanawaka Shale	3700	
Shale-Lime	3310	3365	Douglas Sand	3938	
Lime	3365	3540	Brown Lime	4065	
Shale-Lime	3540	3670	Lansing	4075	
Shale-Lime-Shells	3670	3710	Mississippi	4654	
Shale	3710	3800	Kinderhook	4808	
Shale-Sandy Lime	3800	3870	Viola	4967	
Sandy Shale	3870	3915	Simpson	5104	
Lime-Sand	3915	3960			

F. J. Wentworth
 Superintendent

Subscribed and sworn to before me this 22 day of October, 1952

Don Wise
 Notary Public
 CORPORATION COMMISSION
 OCT 23 1952
 10-23-52
 CONSERVATION DIVISION
 Wichita, Kansas

My Commission Expires August 14, 1954

PLUGGIN
 FILE SEC-34T-33S-14W
 BOOK PAGE 53 LINE 12

WILLIAM A. WHEATS #1

1980' from the West Line (FWL) and
660' from the North Line (FNL) of
the Northwest Quarter (NW/4) of
Section 34-33S-14W, Barber County,
Kansas.

FORMATION LOG

0'-185'	Shale
185'-405'	Sand-Red bead-shale
405'-1050'	Red bed, & sand
1050'-1115'	Shale & shells
1115'-1420'	Red rock & shale
1420'-1625'	Shale & shells
1625'-2050'	Lime & shale
2050'-2405'	Lime
2405'-2505'	Sandy lime
2505'-2565'	Lime
2565'-2690'	Lime & shale
2690'-2780'	Shale & shells
2780'-2855'	Shale & lime
2855'-2955'	Sand & shale
2955'-3005'	Lime & shale
3005'-3075'	Shale, lime & shells
3075'-3155'	Sand & shale
3155'-3270'	Lime & shale
3270'-3310'	Sand & shells
3310'-3365'	Lime & shale
3365'-3410'	Lime
3410'-3540'	Lime
3540'-3670'	Lime & shale
3670'-3710'	Shale & lime & shells
3710'-3800'	Shale
3800'-3870'	Shale, sand & lime
3870'-3915'	Sandy shale
3915'-3960'	Lime & sand
3960'-3985'	Lime & shale
3985'-4030'	Sandy lime & shale
4030'-4080'	Lime & shale
4080'-4105'	Lime
4105'-4155'	Lime & sand
4155'-4180'	Lime
4180'-4795'	Lime
4795'-4815'	Shale & lime
4815'-4835'	Lime & shale
4835'-4855'	Shale
4855'-4875'	Shale & lime
4875'-4895'	Lime
4895'-4905'	Lime & shale
4905'-4940'	Shale & lime
4940'-4958'	Lime & shale
4958'-4978'	Shale & lime
4978'-5010'	Lime
5010'-5040'	Lime & shale
5040'-5105'	Lime
5105'-5135'	Lime & shale
5135'-5151'	Lime, shale & sand
5151'-5200'	Lime & shale
5200'-5220'	Lime
5220'	Total depth

RECEIVED
STATE CONSERVATION COMMISSION

OCT 28 1952
10-22-52
CONSERVATION DIVISION
Wichita, Kansas

