


Give All Information Completely
Make Required Affidavit
Mail or Deliver Report to:
Conservation Division
State Corporation Commission
212 No. Market
Wichita, Kansas

WELL PLUGGING RECORD

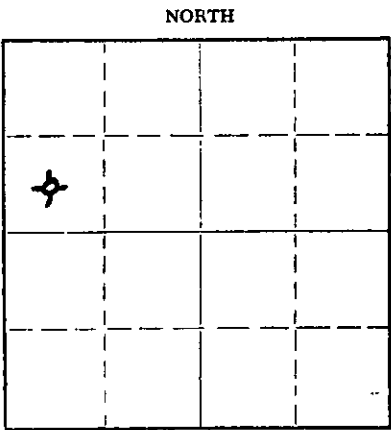

Locate well correctly on above
Section Plat

Barber County, Sec. 31 Twp. 33S Rge. 14(W)
Location as "NE/CNW%SW%" or footage from lines. Ctr. SW/4 NW/4
Lease Owner Champlin Petroleum Company
Lease Name Davis Ranch "F" Well No. 1
Office Address P. O. Box 308, Ellinwood, Kansas
Character of Well (completed as Oil, Gas or Dry Hole) Gas
Date well completed October 27 19 60
Application for plugging filed December 19 19 67
Application for plugging approved January 8 19 68
Plugging commenced January 8 19 68
Plugging completed January 20 19 68
Reason for abandonment of well or producing formation Well will not produce

If a producing well is abandoned, date of last production September 11 19 67
Was permission obtained from the Conservation Division or its agents before plugging was commenced? Yes

Name of Conservation Agent who supervised plugging of this well A. Elving
Producing formation Depth to top Bottom Total Depth of Well 4982 Feet
Show depth and thickness of all water, oil and gas formations.

OIL, GAS OR WATER RECORDS

CASING RECORD

FORMATION	CONTENT	FROM	TO	SIZE	PUT IN	PULLED OUT
				13 3/8" OD	200	None
				5 1/2" OD	4982'	4240'
RECEIVED STATE CORPORATION COMMISSION JAN 24 1968 CONSERVATION DIVISION Wichita, Kansas						

Describe in detail the manner in which the well was plugged, indicating where the mud fluid was placed and the method or methods used in introducing it into the hole. If cement or other plugs were used, state the character of same and depth placed, from feet to feet for each plug set.

Filled hole with sand from 4982' TD to 4900'. Mixed and dumped 5 sacks of cement with dump bailer on top of sand. Filled hole with mud to 208' and built 10' rock bridge and dumped 60 sacks of cement on bridge and then mudded hole to 25' and set 10' rock bridge with 15 sacks of cement filling hole to bottom of cellar.

(If additional description is necessary, use BACK of this sheet)
Name of Plugging Contractor Pipe Pullers, Inc.
Address P. O. Box 486, Ellinwood, Kansas

STATE OF Kansas, COUNTY OF Barton, ss.
J. W. Meyers (employee of owner) or (owner's representative) of the above-described well, being first duly sworn on oath, says: That I have knowledge of the facts, statements, and matters herein contained and the log of the above-described well as filed and that the same are true and correct. So help me God.

(Signature) J. W. Meyers, Dist. Opt's. Manager
P. O. Box 308, Ellinwood, Kansas
(Address)

SUBSCRIBED AND SWORN TO before me this 22nd day of January, 19 68

My commission expires 5/22/70 Notary Public.

RECEIVED
OIL CORPORATION COMMISSION


CHAMPLIN PETROLEUM COMPANY
FORMATION LOG
DAVIS RANCH "F" #1
C SE NW SEC. 31-33S-14W
BARBER COUNTY, KANSAS

MAR 15 1967
3-15-67
CORRELATION DIVISION
WALL, KANSAS

Surface Soil, Shale & Sand	0	50
Redbed and Shells	50	200
Shale, Shells & Redbed	200	1500
Shale & Lime	1500	2125
Lime	2125	2295
Lime & Shale	2295	2475
Lime	2475	2540
Shale & Lime	2540	3730
Lime	3730	3785
Lime & Shale	3785	4290
Lime	4290	4770
Lime & Shale	4770	4917
Mississippi Chert	4917	4932
Mississippi	4932	4974
Lime	4974	4982
<u>Total Depth</u>	4982	

I certify that this is a true and correct copy of the above log to the best of my knowledge.

Champlin Petroleum Company

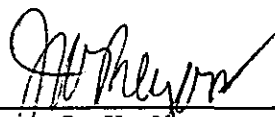
By: J. W. Meyers
District Operations Mgr.

Subscribed and sworn to before me this 14th day of March, 1967.

Notary Public 
N. K. Stivers

My Commission Expires:

5/22/70