

15-007-00191-0000

STATE OF KANSAS
STATE CORPORATION COMMISSION


WELL PLUGGING RECORD

Give All Information Completely
Make Required Affidavit
Mail or Deliver Report to:
Conservation Division
State Corporation Commission
800 Biting Building
Wichita, Kansas

Barber County, Sec. 24 Twp. 33S Rge. 14 xxx W (W)

Location as "NE/CNW/SW" or footage from lines Ctr of SW 1/4 NE 1/4 NW 1/4
Lease Owner Lion Oil Company
Lease Name Baier "B" Well No. 1
Office Address Box 639, Pratt, Kansas
Character of Well (completed as Oil, Gas or Dry Hole) Dry Hole
Date well completed April 28, 19 55
Application for plugging filed May 18, 19 55
Application for plugging approved May 20, 19 55
Plugging commenced May 31, 19 55
Plugging completed June 3, 19 55
Reason for abandonment of well or producing formation Dry Hole

NORTH

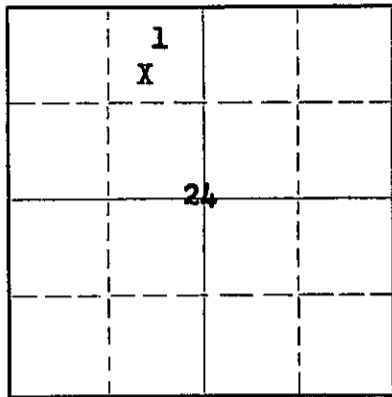

Locate well correctly on above
Section Flat

If a producing well is abandoned, date of last production 19
Was permission obtained from the Conservation Division or its agents before plugging was commenced? Yes

Name of Conservation Agent who supervised plugging of this well Merle Rives
Producing formation Depth to top Bottom Total Depth of Well 4924 Feet
Show depth and thickness of all water, oil and gas formations. Plugged Back. T. D. 4712 "

OIL, GAS OR WATER RECORDS

CASING RECORD

FORMATION	CONTENT	FROM	TO	SIZE	PUT IN	PULLED OUT
				8-5/8"	260'	None
				5-1/2"	4914'	2385'

Describe in detail the manner in which the well was plugged, indicating where the mud fluid was placed and the method or methods used in introducing it into the hole. If cement or other plugs were used, state the character of same and depth placed, from feet to feet for each plug set.

Filled the hole with sand from 4712' to 4695' and ran 5 sacks cement.
Mudded the hole to 250', set 10' rock bridge and ran 20 sacks of cement at 240'. Mudded the hole to 35', set 10' rock bridge and ran 10 sacks of cement on top. Plugging completed.

(If additional description is necessary, use BACK of this sheet)

Name of Plugging Contractor West Supply Co., Inc.
Address Chase, Kansas


STATE OF KANSAS, COUNTY OF PRATT, ss.
Vernon Hayes (employee of owner) of the above-described well, being first duly sworn on oath, says: That I have knowledge of the facts, statements, and matters herein contained and the log of the above-described well as filed and that the same are true and correct. So help me God.

(Signature) *Vernon Hayes*
Box 639, Pratt, Kansas (Address)

SUBSCRIBED AND SWORN TO before me this 9th day of June 19 55

My commission expires August 29, 1955

Dan D... Notary Public.
NOTARY PUBLIC
STATE OF KANSAS

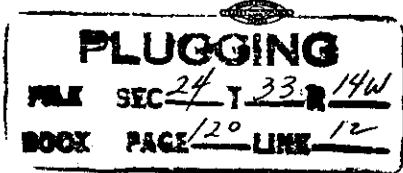

6-10-55
JUN 10 1955

NO. 1 BAYER "B"

WELL RECORD

Location: Ctr S¹/₄ NE NW, 24-33S-14W
Barber County, Kansas

Commenced: March 30, 1955

Operator: Lion Oil Company
211 N-E-N Building, Wichita, Kans.

Completed: April 16, 1955

Elevations:

Contractor: Graham-Messman-Rinehart Drilling Co.
1005 East Second, Wichita, Kansas

Productions:

Casing Record: 8 5/8" @ 259' w/150 sacks cement
5 1/2" @ 4916' w/200 sacks cement

....L O G....

Clay-Sand-Red Bed	273
Red Bed-Shale	1145
Shale	1700
Red Bed-Shale-Gyp	2070
Shale-Lime	2260
Lime-Shale	2414
Shale-Lime	2535
Lime-Shale	2836
Shale-Lime	3006
Lime-Shale	3520
Shale-Lime	3635
Lime-Shale	3726
Shale-Lime	3838
Lime-Shale	4066
Shale-Lime	4139
Lime-Shale	4282
Lime	4435
Lime-Shale	4503
Lime	4699
Core #1 - Lime	4716
Core #2 - Lime	4739
Lime-Shale	4787
Lime-Chert	4795
Lime	4825
Mississippi	4827
Lime	4870
Mississippi	4920
Lime-Shale	4925 R.T.D. (Sj T.D.-4924')

The undersigned, GRAHAM-MESSMAN-RINEHART DRILLING COMPANY, hereby certifies that the above log is a true and correct log of the formation encountered in drilling the above well as reflected by the Daily Drilling Report.

GRAHAM-MESSMAN-RINEHART DRILLING COMPANY

By: J. I. Gilliland
J. I. Gilliland

Subscribed and sworn to before me
this 22nd of April 1955.

PLUGGING	
WELL	SEC 24 T 33 R 14W
DATE	APR 12 1955

6-10-55

J. L. Lewis
Notary Public